

OCT 28 1980

15-151-20811-50-80

FORM CP-4

STATE OF KANSAS
STATE CORPORATION COMMISSION

WELL PLUGGING RECORD

Give All Information Completely
Make Required Affidavit
Mail or Deliver Report to
Conservation Division
State Corporation Comm.
245 North Water
Wichita, KS 67202

Pratt County, Sec. 6 Twp. 29S Rge. 12W 1/2 NW
Location as "NE/CNW 1/4 SW 1/4" or footage from lines
E/2 SW/4 SE/4


Lease Owner Gear Petroleum Company, Inc.
Lease Name Riffey Well No. 1
Office Address 300 Sutton Place, Wichita, Ks. 67202
Character of Well (Completed as Oil, Gas or Dry Hole) D & A

Date Well completed October 21, 1980
Application for plugging filed October 21, 1980
Application for plugging approved October 21, 1980
Plugging commenced October 22, 1980
Plugging completed October 22, 1980

Reason for abandonment of well or producing formation D & A
If a producing well is abandoned, date of last production 19

Was permission obtained from the Conservation Division or its agents before plugging was commenced? Yes

Name of Conservation Agent who supervised plugging of this well Wm. T. Owen
Producing formation _____ Depth to top _____ Bottom _____ Total Depth of Well 4,670'
Show depth and thickness of all water, oil and gas formations.

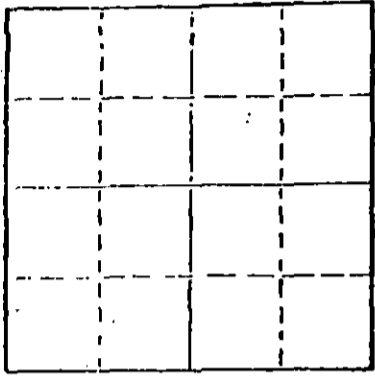

Locate well correctly on above Section Plat

OIL, GAS OR WATER RECORDS

CASING RECORD

FORMATION	CONTENT	FROM	TO	SIZE	PUT IN	PULLED OUT
				8 5/8"	915'	-0-

Describe in detail the manner in which the well was plugged, indicating where the mud fluid was placed and the method or methods used in introducing it into the hold. If cement or other plugs were used, state the character of same and depth placed, from _____ feet to _____ feet for each plug set.

Plugged hole @ 900' w/50 sx cement.
Second plug @ 540' w/40 sx cement
Third plug @ 40' w/10 sx cement
10 sx cement in rathole

RECEIVED
STATE CORPORATION COMMISSION
NOV 5 1980 11-5-80

(If additional description is necessary, use BACK of this sheet)
Name of Plugging Contractor Red Tiger Drilling Company
1720 KSB&T Building, Wichita, Kansas 67202

STATE OF Kansas COUNTY OF Sedgwick
Gloria Fawcett (employee of _____), ss. contractor

of the above-described well, being first duly sworn on oath, says: That I have knowledge of the facts, statements, and matters herein contained and the log of the above-described well as filed and that the same are true and correct. So help me God.

(Signature) Gloria Fawcett
1720 KSB&T Building, Wichita, Kansas 67202
(Address)

SUBSCRIBED AND SWORN TO before me this 27th day of October, 1980.

Joyce A. Baer
Notary Public.

My commission expires _____



OC 28 1980

DRILLERS LOG

No. 1 Riffey

CASING RECORD:	COMPANY:	Gear Petroleum Company, Inc.	DESCRIPTION:
8 5/8" @ 915'	CONTRACTOR:	Red Tiger Drilling Company	E/2 SW/4 SE/4
w/600 sx cement	COMMENCED:	October 6, 1980	Sec. 6-T29S-R12W
D & A	COMPLETED:	October 22, 1980	Pratt County, Kansas
TOTAL DEPTH: 4,670'			ELEVATION: 1,920' GL

<u>FORMATION</u>	<u>FROM</u>	<u>TO</u>	<u>REMARKS</u>
Sand	0	150	
Sand & Red Bed	150	485	
Red Bed & Clay	485	960	
Clay & Shale	960	1640	
Shale & Lime	1640	1935	
Shale	1935	2090	
Lime & Shale	2090	2190	
Shale & Lime	2190	2370	
Lime & Shale	2370	4440	
Lime	4440	4460	
Lime & Shale	4460	4525	
Lime	4525	4590	
Lime & Shale	4590	4633	
Lime	4633	4670	
RTD		4670	

I certify that this is a true and correct copy of the above log to the best of my knowledge.

RED TIGER DRILLING COMPANY

Gloria Fawcett
Gloria Fawcett

Subscribed and sworn to before me this 27th day of October, 1980.

Joyce A. Baer
Notary Public



RECEIVED
STATE CORPORATION COMMISSION
NOV - 5 1980
CONSERVATION DIVISION
Wichita, Kansas