


Give All Information Completely
Make Required Affidavit
Mail or Deliver Report to:
Conservation Division
State Corporation Commission
211 No. Broadway
Wichita, Kansas

WELL PLUGGING RECORD

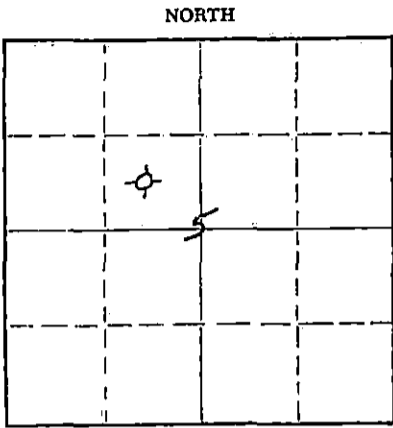

Locate well correctly on above
Section Plat

Pratt County. Sec. 5 Twp. 29 Rge. (E) 12 (W)
Location as "NE/CNW/SW" or footage from lines C SE NW
Lease Owner Burch Exploratin, Inc., & National Associated Pet.
Lease Name Hearn Well No. 1
Office Address 1011 Union Center, Wichita, Kansas
Character of Well (completed as Oil, Gas or Dry Hole) dry hole
Date well completed May 17 1965
Application for plugging filed May 21, 1965
Application for plugging approved _____ 19____
Plugging commenced 11:00 a.m., May 17 1965
Plugging completed 1:00 p.m., May 17 1965
Reason for abandonment of well or producing formation dry hole

If a producing well is abandoned, date of last production _____ 19____
Was permission obtained from the Conservation Division or its agents before plugging was commenced? yes

Name of Conservation Agent who supervised plugging of this well Archie Elvins
Producing formation _____ Depth to top _____ Bottom _____ Total Depth of Well _____ Feet
Show depth and thickness of all water, oil and gas formations.

OIL, GAS OR WATER RECORDS

CASING RECORD

FORMATION	CONTENT	FROM	TO	SIZE	PUT IN	PULLED OUT
		0'	350'	8 5/8	350'	none

Describe in detail the manner in which the well was plugged, indicating where the mud fluid was placed and the method or methods used in introducing it into the hole. If cement or other plugs were used, state the character of same and depth placed, from _____ feet to _____ feet for each plug set.

Bottom Plug @ 300 ft. with 1/4 sack hulls and 25 sx cement.
Top plug @ 40' with 1/2 sack hulls and 10 sx cement.
2X sx cement in rat hole.

RECEIVED
STATE CORPORATION COMMISSION

MAY 24 1965

05-24-65

CONSERVATION DIVISION
Wichita, Kansas

(If additional description is necessary, use BACK of this sheet)

Name of Plugging Contractor Vaughan Drilling, Inc.
Address Box 825, Great Bend, Kansas

STATE OF KANSAS, COUNTY OF BARTON, ss.
~~XXXXXX~~ Wayne Dobbs (employee of owner) or (owner or operator) of the above-described well, being first duly sworn on oath, says: That I have knowledge of the facts, statements, and matters herein contained and the log of the above-described well as filed and that the same are true and correct. So help me God.

(Signature) Wayne Dobbs
Vaughan Drilling, Inc., by: ~~XXXXXX~~ Wayne Dobbs, V-Pres.
Box 825, -Great Bend, Kansas) (Address)

SUBSCRIBED AND SWORN TO before me this 21st day of May, 19 65

My commission expires Jan. 24, 1968

Dorothy Lilly
Notary Public.

WELL LOG

COMPANY Burch Exploration, Inc. & National Associated Pet.
 CONTRACTOR Vaughan Drilling, Inc.
 FARM #1 HEARN.
 LOCATION C SE NW of sec. 5-29-12W
 Pratt County, Kansas
 ELEVATION 1895 K. B.
 SURFACE PIPE 8 5/8" set at 350' with 300 sx HA-5 cement.
 PRODUCTION D & A.
 COMMENCED 5-1-65
 COMPLETED 5-17-65

<u>FORMATION</u>	<u>DEPTH</u>
Surface Clay	35
Sandstone	45
Clay & Sand Streak	80
Sandstone	235
Red Bed	620
Red Shale & Shells	820
Shale & Shells	1590
Limestone & Shale	3201
Limestone	3330
Limestone & Shale	3515
Limestone	4284
Limestone & Chert	4323
Mississippi Limestone & Chert	4342
Mississippi	4372
Shale & Limestone	4450
Chert & Limestone	4510
Viola	4535
Limestone	4555
Sandstone	4560
Simpson Sand	4569
Sandstone	4576
Sandstone & Shale	4624
Shale & Limestone	4670
Rotary Total Depth	4670

FORMATION TOPS

Anhydrite	740 (+1155)
Heebner	3629 (-1734)
Toronto	3646 (-1751)
Douglas Sand	3661 (-1766)
Brown Lime	3812 (-1917)
Top Lansing	3830 (-1935)
Mississippi	4291 (-2396)
Kinderhook	4371 (-2476)
Viola	4423 (-2528)
Simpson Shale	4540 (-2645)
Simpson Dolomite	4549 (-2654)
Simpson Sand	4554 (-2659)
Arbuckle	4656 (-2761)
Rotary Total Depth	4670 (-2775)

RECEIVED
 STATE CORPORATION COMMISSION
 MAY 24 1965
 CONSERVATION DIVISION
 Wichita, Kansas

A F F I D A V I T

STATE OF KANSAS., COUNTY OF BARTON, SS:

I, Wayne Dobbins, of the VAUGHAN DRILLING, INC., being first duly sworn on oath, state; that I have knowledge of the facts, statements and matters herein contained and that the same are true and correct.

Wayne Dobbins
 Wayne Dobbins

Subscribed and sworn to before me this 21st day of May, 1965.

My commission expires: Jan. 24, 1968

Dorothy Tully
 Dorothy Tully, Notary Public