

15-151-21272-00-00


STATE OF KANSAS  
STATE CORPORATION COMMISSION

WELL PLUGGING RECORD

Give All Information Completely  
Make Required Affidavit  
Mail or Deliver Report to  
Conservation Division  
State Corporation Comm.  
245 North Water  
Wichita, KS 67202

Pratt County, Sec. 3 Twp. 29 Rge. 12 ExW  
Location as "NE/CNW $\frac{1}{4}$ /SW $\frac{1}{4}$ " or footage from lines  
150' W of C NW SW

Lease Owner Hummon Corporation  
Lease Name Eckell Well No. 1  
Office Address 400 One Main Place, Wichita, KS 67202  
Character of Well (Completed as Oil, Gas or Dry Hole)  
Dry Hole (c)(L)  
Date Well completed 5-17 1983  
Application for plugging filed 5-16 1983  
Application for plugging approved 5-16 1983  
Plugging commenced 5-17 1983  
Plugging completed 5-17 1983  
Reason for abandonment of well or producing formation

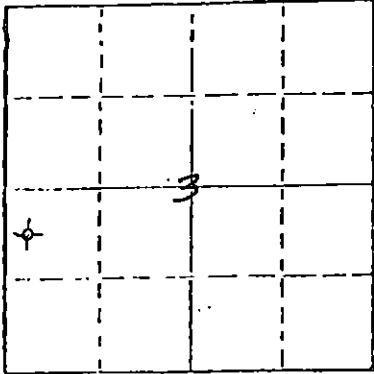

Locate well correctly on above  
Section Plot

If a producing well is abandoned, date of last production  
19

Was permission obtained from the Conservation Division or  
its agents before plugging was commenced? Yes

Name of Conservation Agent who supervised plugging of this well Richard Lacey, Dodge City  
Producing formation Depth to top Bottom Total Depth of Well  
Show depth and thickness of all water, oil and gas formations. RTD 4495'

OIL, GAS OR WATER RECORDS

CASING RECORD

FORMATION	CONTENT	FROM	TO	SIZE	PUT IN	PULLED OUT
	Surface	0	308	8-5/8	yes	no

Describe in detail the manner in which the well was plugged, indicating where the mud fluid  
was placed and the method or methods used in introducing it into the hold. If cement or other  
plugs were used, state the character of same and depth placed, from feet to  
feet for each plug set.

- 1st plug @ 810' w/ 40 sx.
- 2nd plug @ 360' w/ 50 sx.
- Bridge @ 40' w/ 10 sx.
- 10 sx. in mousehole
- 10 sx. in rathole
- 10 sx. in water well
- Job complete @ 11:00 a.m. 5/17/83

(If additional description is necessary, use BACK of this sheet)

Name of Plugging Contractor Big-H Drilling, Inc.

STATE OF KANSAS COUNTY OF SEDGWICK, ss.

Wilber Berg of Hummon Corporation (employee of owner) or (owner or operator)  
of the above-described well, being first duly sworn on oath, says: That I have knowledge of  
the facts, statements, and matters herein contained and the log of the above-described well  
as filed and that the same are true and correct. So help me God.

(Signature) Wilber D Berg  
400 One Main Place, Wichita, KS 67202  
(Address)

SANDRA L. MENDOZA  
NOTARY PUBLIC  
SEDGWICK COUNTY, KANSAS  
MY APPT. EXP.

TO before me this 20<sup>th</sup> day of May, 1983

Sandra L. Mendoza  
Notary Public.

My commission expires 2/13/86

RECEIVED  
STATE CORPORATION COMMISSION

MAY 24 1983

CONSERVATION DIVISION  
Wichita, Kansas