


STATE OF KANSAS
STATE CORPORATION COMMISSION
CONSERVATION DIVISION
P. O. BOX 17027
WICHITA, KANSAS 67217

WELL PLUGGING RECORD

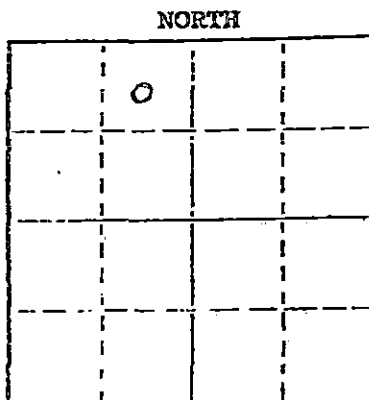

Locate well correctly on above
Section Plat

Pratt County, Sec. 35 Twp. 29S Rge. 11W (E) (W)
Location as "NE/CNW/SW" or footage from lines C NE NW
Lease Owner Glen N. Rupe
Lease Name Harding Washdown Well No. 1
Office Address 925 Olive Garvey Building, 200 West Douglas, Wichita KS
Character of Well (completed as Oil, Gas or Dry Hole) Dry Hole 67202
Date well completed May 21, 19 75
Application for plugging filed May 20, 19 75
Application for plugging approved May 20, 19 75
Plugging commenced May 20, 19 75
Plugging completed May 21, 19 75
Reason for abandonment of well or producing formation Dry Hole
If a producing well is abandoned, date of last production 19
Was permission obtained from the Conservation Division or its agents before plugging was commenced? Yes

Name of Conservation Agent who supervised plugging of this well Russell Beavenstein
Producing formation None Depth to top Bottom Total Depth of Well 3636 Feet
Show depth and thickness of all water, oil and gas formations.

OIL, GAS OR WATER RECORDS

CASING RECORD

FORMATION	CONTENT	FROM	TO	SIZE	PUT IN	PULLED OUT

Describe in detail the manner in which the well was plugged, indicating where the mud fluid was placed and the method or methods used in introducing it into the hole. If cement or other plugs were used, state the character of same and depth placed, from feet to feet for each plug set.

Plugged: 40 sacks @ 250, Mud to 40 feet, Plug and
bridge to hold kelly, 65 sacks to base of cellar,
2 sacks in rathole, 2 sacks in mouse hole.
Completed: 1:00 PM 5-21-75 by Halliburton.

RECEIVED
STATE CORPORATION COMMISSION
6-9-75
JIN 01075

CONSERVATION DIVISION
Wichita, Kansas

(If additional description is necessary, use BACK of this sheet)

Name of Plugging Contractor DaMac Drilling Company, Inc.
Address Box 1164, Great Bend, Kansas 67530

STATE OF Kansas COUNTY OF Barton, ss.


(employee of owner) or (owner or operator) of the above-described well, being first duly sworn on oath, says: That I have knowledge of the facts, statements, and matters herein contained and the log of the above-described well as filed and that the same are true and correct. So help me God.

(Signature) Florida Taylor

Box 1164, Great Bend, Kansas 67530
(Address)

Subscribed and Sworn to before me this 3rd day of June, 19 75

My commission expires

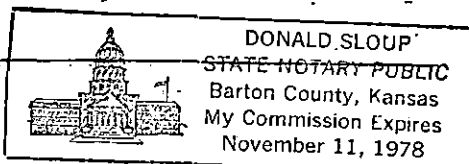

Donald Sloup
Notary Public.