


15.151-20337-6D.00.

STATE OF KANSAS
STATE CORPORATION COMMISSION
CONSERVATION DIVISION
P. O. BOX 17027
WICHITA, KANSAS 67217

FORM CP-4

WELL PLUGGING RECORD

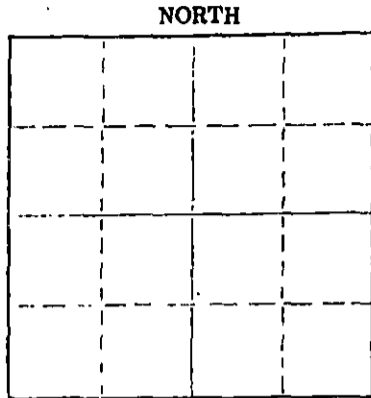

Locate well correctly on above Section Plat

Pratt County, Sec. 35 Twp. 29S Rge. (E)11 (W)
Location as "NE/CNW/SE/SW" or footage from lines C NE
Lease Owner Ronald Russ Prater, Inc.
Lease Name Simon Well No. 1
Office Address #235 - 240 North Rock Road - Wichita, Kansas 67206
Character of Well (completed as Oil, Gas or Dry Hole) Dry Hole
Date well completed June 14, 1976
Application for plugging filed June 14, 1976
Application for plugging approved June 14, 1976
Plugging commenced June 14, 1976
Plugging completed June 14, 1976
Reason for abandonment of well or producing formation Dry hole

If a producing well is abandoned, date of last production 19
Was permission obtained from the Conservation Division or its agents before plugging was commenced? yes

Name of Conservation Agent who supervised plugging of this well George Russell Bieberstein
Producing formation _____ Depth to top _____ Bottom _____ Total Depth of Well 2920 Feet
Show depth and thickness of all water, oil and gas formations.

OIL, GAS OR WATER RECORDS

CASING RECORD

FORMATION	CONTENT	FROM	TO	SIZE	PUT IN	PULLED OUT
	Surface					
	Casing	0	288	8 5/8"	288'	none

Describe in detail the manner in which the well was plugged, indicating where the mud fluid was placed and the method or methods used in introducing it into the hole. If cement or other plugs were used, state the character of same and depth placed, from _____ feet to _____ feet for each plug set.

Plugged to 250 feet with 35 sacks cement,
mud to 40' - 15 sacks cement, 5 sacks cement
in rat hole. Job completed at 12:30 P.M.

RECEIVED
STATE CORPORATION COMMISSION
6-16-76
JUN 16 1976

CONSERVATION DIVISION
Wichita, Kansas

(If additional description is necessary, use BACK of this sheet)

Name of Plugging Contractor Search DRilling Company
Address P. O. Box 18148 - Wichita, Kansas 67218

STATE OF Kansas COUNTY OF Sedgwick, ss.

_____, (employee of owner) or (owner or operator) of the above-described well, being first duly sworn on oath, says: That I have knowledge of the facts, statements, and matters herein contained and the log of the above-described well as filed and that the same are true and correct. So help me God.

(Signature) R. M. Wendling
Wichita, Kansas
(Address)

SUBSCRIBED AND SWORN TO before me this 15th day of June, 1976

My commission expires February 19, 1977
Maxine Dressen
Notary Public.

MAXINE DRESSEN
NOTARY PUBLIC
SEDGWICK COUNTY, KANSAS
MY COMM. EXP. FEB. 19, 1977

DRILLERS LOG

SIMON #1

CASING RECORD:
8 5/8" set at 288'
with 275 sacks cement

OPERATOR: Ronald Russ Prater, Inc.

DESCRIPTION:

CONTRACTOR: Search Drilling Company

C NE
Section 35-29S-11W
Pratt County,
Kansas

TOTAL DEPTH:

COMMENCED: June 10, 1976

2920'

COMPLETED: June 14, 1976

<u>FORMATION</u>	<u>FROM</u>	<u>TO</u>	<u>REMARKS</u>
Sand	0	220	
RedBed and Shale	220	288	
Shale	288	880	
Shale	880	1193	
Shale	1193	1611	
Shale	1611	1758	
Lime and Shale	1758	1870	
Shale and Lime	1870	2122	
Shale and Lime	2122	2343	
Shale and Lime	2343	2528	
Lime and Shale	2528	2658	
Lime and Shale	1568	2726	
Lime and Shale	2726	2743	
Lime and Shale	2743	2920	
RTD	2920		

RECEIVED
STATE COMMISSION COMMISSION
JUN 16 1976
CONSERVATION DIVISION
Wichita, Kansas

D & A

I certify that this is a true and correct copy of the above log to the best of knowledge.

SEARCH DRILLING COMPANY

R. M. Wendling
R. M. Wendling

Subscribed and sworn to before me this 15th day of June, 1976.

My commission expires:

February 13, 1977
MAXINE DRESSEN
 NOTARY PUBLIC
 SEDGWICK COUNTY, KANSAS
 MY COMM. EXP. FEB. 13, 1977

Maxine Dressen
Maxine Dressen Notary Public