


STATE OF KANSAS
STATE CORPORATION COMMISSION

Give All Information Completely
Make Required Affidavit
Mail or Deliver Report to:
Conservation Division
State Corporation Commission
800 Bittling Building
Wichita, Kansas

WELL PLUGGING RECORD

NORTH

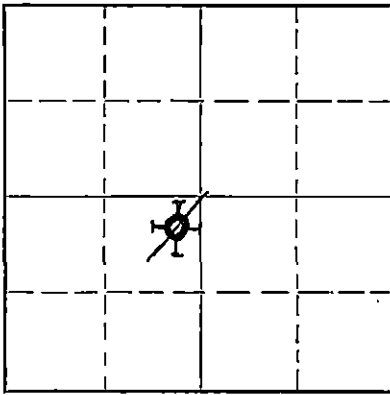

Locate well correctly on above
Section Plat

Pratt County. Sec. 22 Twp. 29S Rge. 11W (E) (W)
Location as "NE/CNW $\frac{1}{4}$ SW $\frac{1}{4}$ " or footage from lines NE NE SW
Lease Owner Bachus Oil Company
Lease Name Knop Well No. 3
Office Address 721 E. Central, Wichita, Kansas
Character of Well (completed as Oil, Gas or Dry Hole) Disposal
Date well completed 8/31/67 19
Application for plugging filed 9/30/70 19
Application for plugging approved 10/1/70 19
Plugging commenced 10/20/70 19
Plugging completed 10/28/70 19
Reason for abandonment of well or producing formation

If a producing well is abandoned, date of last production 19
Was permission obtained from the Conservation Division or its agents before plugging was commenced? Yes

Name of Conservation Agent who supervised plugging of this well G. Russell Biberstein
Producing formation Disposal Well Depth to top Bottom Total Depth of Well 4824 Feet
Show depth and thickness of all water, oil and gas formations.

OIL, GAS OR WATER RECORDS

CASING RECORD

Formation	Content	From	To	Size	Put In	Pulled Out
Arbuckle	Salt Water	-0- 4776	366 4824	8 5/8 5 1/2	366 4776	-0- 3267

Describe in detail the manner in which the well was plugged, indicating where the mud fluid was placed and the method or methods used in introducing it into the hole. If cement or other plugs were used, state the character of same and depth placed, from feet to feet for each plug set.

Fill hole with chat from 4824 to 4766
Dump 5 sacks cement from 4766 to 4731
Ripped pipe at 4000, 3750, 3500, 3250, and 3100
Build wood bridge and fill hole with 10' rock at 270
Fill hole from 270 to top of hole with 4 1/2 yards of Ready-Mix

RECEIVED
STATE CORPORATION COMMISSION
NOV 23 1970
CONSERVATION DIVISION
Wichita, Kansas

11-23-70

Plugged by Clarke Corporation, Box 187, Medicine Lodge, Kansas

(If additional description is necessary, use BACK of this sheet)

Correspondence regarding this well should be addressed to Bachus Oil Company
Address 721 E. Central, Wichita, Kansas

STATE OF KANSAS, COUNTY OF Sedgwick, ss.
D. Bachus

(employee of owner) or (owner or operator) of the above-described well,
being first duly sworn on oath, says: That I have knowledge of the facts, statements, and matters herein contained and the log of the above-described well, and that the same are true and correct. So help me God.

(Signature) D. Bachus
721 E. Central, Wichita, Kansas
(Address)

Subscribed and sworn to before me this 20th day of November, 1970.

My commission expires January 26, 1973

Nelson R. Thomas
Notary Public.

D. R. Lauck Oil Company, Inc.

#3 Knop

NE NE SW Sec. 22-29S-11W
Pratt County, Kansas

Commenced: July 17, 1967

Completed: July 30, 1967

Casing Record: 366' 8-5/8" Cemented with 250 sacks Cement
5 sacks Calcium Chloride.
4776' 5-1/2" Cemented with 75 sacks Common
Salt Saturated Cement.

Elevation: GL 1817; DF 1819; KB 1821.

RECEIVED
OCT 1 1970
KANSAS CORPORATION COMMISSION
CONSERVATION DIVISION
Wichita, Kansas

Drillers Log

Tops

Clay	32
Sand	152
Sand & Shale	170
Red Bed	735
Shale	1038
Shale & Shells	1685
Shale & Lime	1770
Lime & Shale	2674
Shale & Lime	3325
Lime & Shale	3500
Shale & Lime	3565
Lime	3625
Lime & Shale	3704
Shale	3815
Lime	4305
Lime & Shale	4375
Lime	4421
Shale & Lime	4583
Lime	4618
Lime & Chert	4646
Lime, Chert & Shale	4676
Lime & Shale	4697
Sand	4700
Sand, Lime, Shale	4737
Shale & Lime	4763
Lime	4824

Heebner	3651-1830
Toronto	3675-1854
Douglas	3703-1882
Brown Lime	3815-1994
Lansing	3838-2017
Mississippian	4378-2557
Kinderhook	4422-2601
Viola	4599-2778
Simpson Shale	4676-2855
Simpson Sand	4694-2873
Arbuckle	4763-2942
Total Depth	4824-3003

DST #1 (H) 4674-97, open 30 minutes.
Weak blow and dead in 10
minutes. Recovered 5' mud.
ISIP 34#, 30 min. IFP 17#.
FFP 17#. FSIP 26#, 30 min.

DST #2 (H) 4673-4700, open 1 hour.
Good blow thruout. Recovered
285' muddy water, 285' salt
water. ISIP 1414#, 30 min.
IFP 34#. FFP 272#. FSIP
1328#, 30 min.