


STATE OF KANSAS  
STATE CORPORATION COMMISSION

WELL PLUGGING RECORD

Give All Information Completely  
Make Required Affidavit  
Mail or Deliver Report to:  
Conservation Division  
State Corporation Commission  
212 No. Market  
Wichita, Kansas

Pratt County, Sec. 22 Twp. 29S Rge. 11W (E) (W)

Location as "NE/CNW/SW" or footage from lines SW SW SE  
Lease Owner Loyd Benefield Oil Co.  
Lease Name Knop Well No. 4  
Office Address 2700 Liberty Bank Bldg., Okla. City, Okla.  
Character of Well (completed as Oil, Gas or Dry Hole) Dry Hole  
Date well completed August 4, 1968  
Application for plugging filed August 4, 1968  
Application for plugging approved August 4, 1968  
Plugging commenced August 4, 1968  
Plugging completed August 4, 1968  
Reason for abandonment of well or producing formation Dry Hole

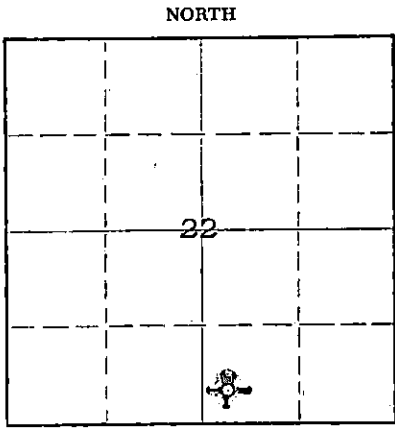

Locate well correctly on above  
Section Plat

If a producing well is abandoned, date of last production 19  
Was permission obtained from the Conservation Division or its agents before plugging was commenced? Yes

Name of Conservation Agent who supervised plugging of this well Ralph Warren  
Producing formation \_\_\_\_\_ Depth to top \_\_\_\_\_ Bottom \_\_\_\_\_ Total Depth of Well 4791 Feet  
Show depth and thickness of all water, oil and gas formations.

OIL, GAS OR WATER RECORDS

CASING RECORD

FORMATION	CONTENT	FROM	TO	SIZE	PUT IN	PULLED OUT
		0'	374'	8-5/8"	374'	None

Describe in detail the manner in which the well was plugged, indicating where the mud fluid was placed and the method or methods used in introducing it into the hole. If cement or other plugs were used, state the character of same and depth placed, from \_\_\_\_\_ feet to \_\_\_\_\_ feet for each plug set.

4791' - 300' Mud  
 300' - 296' Plug  
 296' - 256' Halls and Cement (25 sacks)  
 256' - 40' Mud  
 40' - 36' Plug  
 36' - 6' Halls and Cement (10 sacks)

RECEIVED  
STATE CORPORATION COMMISSION  
AUG 12 1968  
CONSERVATION DIVISION  
Wichita, Kansas

(If additional description is necessary, use BACK of this sheet)  
Name of Plugging Contractor Lauck Drilling Company, Incorporated  
Address 301 S. Broadway, Wichita, Kansas

STATE OF KANSAS, COUNTY OF SEDGWICK, ss.  
John H. Knightley (employee of owner) or (owner or operator) of the above-described well, being first duly sworn on oath, says: That I have knowledge of the facts, statements, and matters herein contained and the log of the above-described well as filed and that the same are true and correct. So help me God.

(Signature) John H. Knightley  
301 S. Broadway, Wichita, Kansas  
(Address)

SUBSCRIBED AND SWORN to before me this 8th day of August, 1968  
Stella J. Lips Notary Public.

My commission expires March 12, 1971

Loyd Benefield Oil Co.

Knop #4

SW SW SE Sec. 22-29S-11W  
Pratt County, Kansas

Commenced: July 22, 1968  
Completed: August 4, 1968

Rotary Drilling Contractor: Lauck Drilling Company, Incorporated.

Casing Record: 374' 8-5/8" Cemented with 250 sacks Cement,  
5 sacks Calcium Chloride.

Elevation: GL 1825; DF 1827; KB 1829.

.....  
Drillers Log

Sand	180
Red Bed	375
Red Bed, Shale & Shells	900
Shale & Shells	1690
Lime & Shale	2115
Broken Lime & Shale	2305
Shale & Lime	2480
Lime & Shale	2625
Shale & Lime	2896
Lime & Shale	3705
Shale	3795
Lime	4125
Lime, cherty	4170
Lime	4355
Chert	4385
Chert & Shale	4420
Lime & Shale	4485
Shale & Lime	4579
Lime & Chert	4594
Lime	4625
Lime & Chert	4646
Lime, Chert, Shale	4681
Dolomite, Sand & Shale	4715
Lime & Shale	4741
Shale & Lime	4764
Lime	4791 RTD

RECEIVED  
STATE CORPORATION COMMISSION  
AUG 12 1968  
CONSERVATION DIVISION  
Wichita, Kansas