


STATE OF KANSAS
STATE CORPORATION COMMISSION

WELL PLUGGING RECORD

Give All Information Completely
Make Required Affidavit
Mail or Deliver Report to
Conservation Division
State Corporation Comm.
245 North Water
Wichita, KS 67202

Pratt County. Sec. 20 Twp. 29 Rge. 11 E/W
Location as "NE/CNW 1/4 SW 1/4" or footage from lines
660 FSL and 380 FWL SE/4

Lease Owner F. G. Holl
Lease Name Miller 2-20 Well No.
Office Address Lyons, Kansas 67554
Character of Well (Completed as Oil, Gas or Dry Hole)

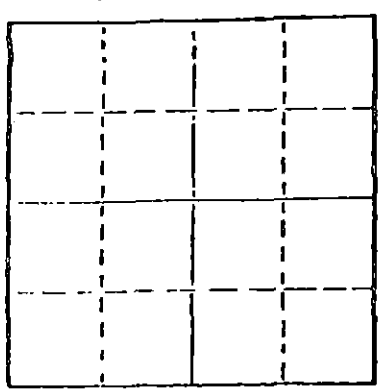

Date Well completed 19
Application for plugging filed 19
Application for plugging approved 19
Plugging commenced 8/24/79 19
Plugging completed 8/27/79 19
Reason for abandonment of well or producing formation depleted.

If a producing well is abandoned, date of last production 19

Was permission obtained from the Conservation Division or its agents before plugging was commenced? yes

Name of Conservation Agent who supervised plugging of this well Owens
Producing formation Depth to top Bottom Total Depth of Well 2815
Show depth and thickness of all water, oil and gas formations.

OIL, GAS OR WATER RECORDS

CASING RECORD

FORMATION	CONTENT	FROM	TO	SIZE	PUT IN	PULLED OUT
				7"	261	none
				4 1/2"	2814	2089'

Describe in detail the manner in which the well was plugged, indicating where the mud fluid was placed and the method or methods used in introducing it into the hold. If cement or other plugs were used, state the character of same and depth placed, from feet to feet for each plug set.

Sanded to 2700' and ran 4 sacks cement. Shot pipe at 2075', pulled 63 joints. Squeezed hole with 8 sacks hulls, ~~XXX~~ 25 sacks gel, released plug and displaced with 75 sacks 50-50 pozmix, 4% gel and 3% cc.

PLUGGING COMPLETE.

(If additional description is necessary, use BACK of this sheet)

Name of Plugging Contractor KELSO CASING PULLING
CHASE, KANSAS

STATE OF KANSAS COUNTY OF RICE, ss.
R. DARRELL KELSO (employee of owner) or (owner or operator)
of the above-described well, being first duly sworn on oath, says: That I have knowledge of the facts, statements, and matters herein contained and the log of the above-described well as filed and that the same are true and correct. So help me God.

(Signature) R. Darrell Kelso
CHASE, KANSAS (Address)

SUBSCRIBED AND SWORN TO before me this 6th day of Sept., 19 79

My commission expires



RECEIVED
STATE CORPORATION COMMISSION
Notary Public.

SEP 10 1979 9-10-79
CONSERVATION DIVISION
Wichita, Kansas