


STATE OF KANSAS
STATE CORPORATION COMMISSION

Form CP-4

WELL PLUGGING RECORD

Give All Information Completely
Make Required Affidavit
Mail or Deliver Report to:
Conservation Division
State Corporation Commission
212 No. Market
Wichita, Kansas

Pratt County. Sec. 20 Twp. 29S Rge. 11W (W)
Location as "NE/CNWxSWx" or footage from lines NW SE SE
Lease Owner Lauck Drilling Company, Incorporated
Lease Name Miller Well No. 1
Office Address 301 S. Broadway, Wichita, Kansas 67202
Character of Well (completed as Oil, Gas or Dry Hole) Dry Hole
Date well completed December 10, 1966
Application for plugging filed December 10, 1966
Application for plugging approved December 10, 1966
Plugging commenced December 10, 1966
Plugging completed December 10, 1966
Reason for abandonment of well or producing formation Dry Hole

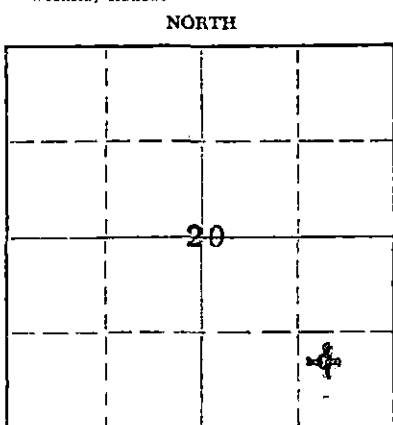

Locate well correctly on above
Section Plat

If a producing well is abandoned, date of last production _____ 19____
Was permission obtained from the Conservation Division or its agents before plugging was commenced? Yes

Name of Conservation Agent who supervised plugging of this well Archie Elving
Producing formation _____ Depth to top _____ Bottom _____ Total Depth of Well 4813 Feet
Show depth and thickness of all water, oil and gas formations.

OIL, GAS OR WATER RECORDS

CASING RECORD

FORMATION	CONTENT	FROM	TO	SIZE	PUT IN	PULLED OUT
		0'	330'	8-5/8"	330'	None

Describe in detail the manner in which the well was plugged, indicating where the mud fluid was placed and the method or methods used in introducing it into the hole. If cement or other plugs were used, state the character of same and depth placed, from _____ feet to _____ feet for each plug set.

4813' - 235' Mud
235' - 231' Plug
231' - 191' Cement, 25 sacks
191' - 40' Mud
40' - 36' Plug
36' - 6' Cement, 10 sacks; 2 sacks in rathole.
(Bottom of cellar)

RECEIVED
STATE CORPORATION COMMISSION

DEC 21 1966

CONSERVATION DIVISION
Wichita, Kansas
12-21-66

(If additional description is necessary, use BACK of this sheet)
Name of Plugging Contractor Sun Cementing Co.
Address Great Bend, Kansas

STATE OF KANSAS, COUNTY OF SEDGWICK, ss.

John H. Knightley (employee of owner) or (owner or operator) of the above-described well, being first duly sworn on oath, says: That I have knowledge of the facts, statements, and matters herein contained and the log of the above-described well as filed and that the same are true and correct. So help me God.

(Signature) John H. Knightley
301 S. Broadway, Wichita, Kansas
(Address)

SUBSCRIBED AND SWORN TO before me this 20th day of December, 19 66

My commission expires March 12, 1967. Stella J. Lipp Notary Public.

Lauck Drilling Company, Incorporated

Miller #1

NW SE SE Sec. 20-29S-11W
Pratt County, Kansas

Commenced: November 26, 1966
Completed: December 10, 1966

Casing Record: 330' 8-5/8" Cemented with 250 sacks Cement,
6 sacks Calcium Chloride.

Elevation: GL 1851; DF 1854; KB 1856.

Drillers Log

Tops

		Sample	Electra
Surface Clay & Sand	105	Anhydrite (driller)	695+1161 699+1157
Sand	210	Heebner	3661-1805 3665-1809
Red Bed	330	Douglas Shale	3687-1831 3690-1834
Red Bed, Shale	500	Douglas Sand	3732-1876
Red Bed	695	Brown Lime	3850-1994 3851-1995
Anhydrite	700	Lansing-Kansas City	3864-2008 3868-2012
Red Bed & Shale	1200	Base Kansas City	4282-2426 4286-2430
Shale	1742	Cherokee Shale	4354-2498
Lime	1980	Cherokee Sand	4364-2508 4366-2510
Lime & Shale	2205	Mississippian	4386-2530 4390-2534
Shale & Lime Streaks	2430	Kinderhook	4499-2643 4476-2620
Lime & Shale	2665	Viola	4637-2781 4638-2782
Shale & Lime	3008	Simpson Shale	4705-2849 4711-2855
Lime & Shale	3997	Simpson Dolomite	4716-2860 4720-2864
Lime	4370	Simpson Sand	4730-2874 4736-2880
Lime & Chert	4410	Arbuckle	4795-2939 4798-2942
Chert & Lime	4451	Total Depth	4813-2957 4818-2962
Lime & Shale	4647		
Lime & Chert	4685		
Lime & Shale	4732		
Sand	4750		
Shale, Lime & Dolomite	4813 RTD		

DST #1 (S) 4374-4410 drilling meas.
4378-4414 Electra meas.
Open 30, shut in 30, open 30, shut
in 30 minutes. Good blow throughout
test. Recovered 60' slightly gas-
cut mud. ISIP 100#, 30 minutes. FSIP
608#, 30 minutes. IFP 41# to 41#.
FFP 41# to 41#.

DST #2 (S) 4723-32 drilling meas.
4729-38 Electra meas.
Open 30, shut in 30, open 30, shut
in 30 minutes. Weak blow increased
to fair blow throughout test.
Recovered 360' muddy water. ISIP
1664#, 30 minutes. IFP 41# to 100#.
FFP 125# to 167#. FSIP 1655#, 30
minutes.

RECEIVED
STATE CORPORATION COMMISSION

DEC 21 1966

CONSERVATION DIVISION
Wichita, Kansas

D&A