

STATE OF KANSAS  
STATE CORPORATION COMMISSION

WELL PLUGGING RECORD

Give All Information Completely  
Make Required Affidavit  
Mail or Deliver Report to  
Conservation Division  
State Corporation Comm.  
245 North Water  
Wichita, KS 67202

Pratt County. Sec. 19 Twp. 29S Rge. 11WE/4  
Location as "NE/CNW/SW" or footage from lines  
660' FSL & 660' FEL


Lease Owner Texas Oil & Gas Corp.  
Lease Name Hartman Well No. 1

Office Address 200 W. Douglas, Suite 300, Wichita, KS  
Character of Well (Completed as Oil, Gas or Dry Hole) 67202  
Dry Hole

Date Well completed January 22, 1979  
Application for plugging filed Verbal Application 19  
Application for plugging approved Verbal Approval 19  
Plugging commenced January 22, 1979  
Plugging completed January 22, 1979  
Reason for abandonment of well or producing formation \_\_\_\_\_

If a producing well is abandoned, date of last production \_\_\_\_\_ 19

Was permission obtained from the Conservation Division or its agents before plugging was commenced? Yes

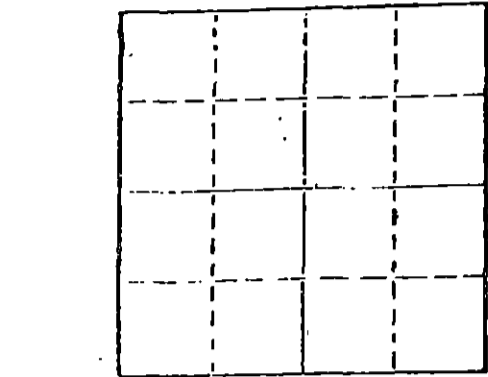

Locate well correctly on above Section Plat

Name of Conservation Agent who supervised plugging of this well Wm. T. Owen  
Producing formation \_\_\_\_\_ Depth to top \_\_\_\_\_ Bottom \_\_\_\_\_ Total Depth of Well 3,950'  
Show depth and thickness of all water, oil and gas formations.

OIL, GAS OR WATER RECORDS

CASING RECORD

FORMATION	CONTENT	FROM	TO	SIZE	PUT IN	PULLED OUT
				8-5/8"	374'	None

Describe in detail the manner in which the well was plugged, indicating where the mud fluid was placed and the method or methods used in introducing it into the hold. If cement or other plugs were used, state the character of same and depth placed, from \_\_\_\_\_ feet to \_\_\_\_\_ feet for each plug set,

Filled hole with heavy rotary mud from 3,950 ft. (rotary total depth) to 600 ft. Set plug at 600 ft. and cemented with 50 sacks cement. Filled hole with heavy rotary mud from 600 ft. to 360 ft. Set plug at 360 ft. and cemented with 40 sacks cement. Filled hole with heavy rotary mud from 360 ft. to 40 ft. Set solid plug at 40 ft. and cemented to cellar with 12 sacks cement. 3 sacks cement in rat hole.

Plugging operations accomplished utilizing Allied Oil Well cementing pump truck through 4 1/2 inch drill pipe.


(If additional description is necessary, use BACK of this sheet)

Name of Plugging Contractor Allied Cementing Co., Inc.  
Box 31, Russell, Kansas 67665

STATE OF Kansas COUNTY OF Sedgwick, ss.  
Dean Britting, Agent ~~XXXXXX~~ of owner ~~XXXXXXXXXXXXXXXXXXXX~~

of the above-described well, being first duly sworn on oath, says: That I have knowledge of the facts, statements, and matters herein contained and the log of the above-described well as filed and that the same are true and correct. So help me God.

(Signature) Dean Britting  
200 N. Main, Wichita, Kansas 67202  
(Address)

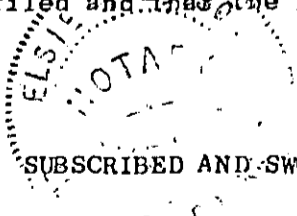

SUBSCRIBED AND SWORN TO before me this 31st day of January, 19 79

Elsie Willison  
Elsie Willison - Notary Public.

My commission expires July 25, 1982

RECEIVED  
STATE CORPORATION COMMISSION

FEB - 1 1979  
02-01-79  
CONSERVATION DIVISION  
Wichita, Kansas

KANSAS DRILLERS LOG

COMPANY Texas Oil & Gas Corp.

SEC. 19 T. 29S R. 11W  
LOC. 650' FSL & 660' FEL

FARM Hartman

NO. 1

COUNTY Pratt

ROTARY TOTAL DEPTH 3,950'

COMM. January 16, 1979

COMP. January 22, 1979

CONTRACTOR H-30, Inc. (Rig #3)

ISSUED January 31, 1979

CASING

10 3/4"

8 5/8" Set at 374' cemented w/350 sxs cement

5 1/2"

4 1/2"

ELEVATION 1,860' K.B.

FIGURES INDICATE BOTTOM OF FORMATIONS

Sand	133'
Red Bed	376'
Shale and Lime	2,615'
Lime and Shale	3,950'
Rotary Total Depth	3,950'

I hereby certify the above and foregoing to be a true and correct log of the above described well as shown by the drilling reports.

H-30, Inc.

*Dean Britting*  
Dean Britting

State of Kansas )  
County of Sedgwick ) SS:

Subscribed and Sworn to before me a Notary Public in and for said county and state this 31st day of January, 1979.

*Elsie Willison*  
Elsie Willison - Notary Public

My Commission Expires:

July 25, 1982

