


15-097-20928-0000
 20555

WELL PLUGGING RECORD

Give All Information Completely
 Make Required Affidavit

COUNTY Kiowa SEC. 8 TWP. 28S RGE. 19 W
 Location as in quarters or footage from lines:
660' FNL & 1980' FWL

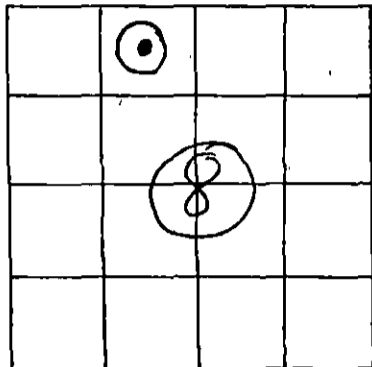

Locate Well
 correctly on above
 Section Platt.

Lease Owner CINCO EXPLORATION COMPANY
 Lease Name L. M. Stevens Well No. 1-A
 Office Address P. O. Box 3723 - Victoria, TX 77903
 Character of Well (Completed as Oil, Gas or Dry Hole) Gas
 Date Well Completed 09/24/79
 Application for plugging filed Yes, approximately 03/15/83
 Plugging commenced 03/25/83
 Plugging completed 03/29/83
 Reason for abandonment of well or producing formation Excessive H₂S content and excessive water.
 Was permission obtained from the Conservation Division or it's Agent's before plugging was commenced? Yes

Name of Conservation Agent who supervised plugging of this well Richard Lacey
 Producing formation Mississippi Depth to top 4892' bottom 4900' T.D. 5215'
 Show depth and thickness of all water, oil and gas formations.

OIL, GAS OR WATER RECORDS

Casing Record

Formation	Content	From	To	Size	Put In	Pulled Out
Sand & Shale	Fresh Water	0	200			
Red Beds & Shale	Brackish Water	200	525	8 5/8"	525	0
Mississippi	Gas	4889	4900	4 1/2"	5155'	3600'

Describe in detail the manner in which the well was plugged, indicating where the mud fluid was placed and the method or methods used in introducing it into the hold. If cement or other plugs were used, state the character of same and depth placed, from feet to feet for each plug set. Filled well with sand from TD to 4800'. Dump bailed 4 sacks of cement on top of sand at 4800'. Top of cement at 4760'. Recovered 3600' of 4 1/2" casing.
Pumped 3 sacks of hulls, 15 sacks of gel, 20 sacks of 50/50 Poz, 20 sacks of gel, 1 sack of hulls, rubber wiper plug and 130 sacks of cement. Tagged top of cement at 65' on following day. Supervised on location by Richard Lacey, Kansas Corporation Commission. Cinco Representative - Mike Rolette

(If additional description is necessary, use BACK of this sheet)

Name of Plugging Contractor Halliburton Services - License No.: 5287

STATE OF TEXAS COUNTY OF VICTORIA, ss.
MELVIN KLOTZMAN (employee of owner) ~~owner or operator~~ of

the above-described well, being first duly sworn on oath, says: That I have knowledge of the facts, statements, and matters herein contained and the log of the above-described well as filed and that the same are true and correct. So help me God.

STATE CORPORATION COMMISSION

(Signature) [Signature]

APR 21 1983

P. O. Box 3723 - Victoria, TX 77903
 (Address)

CONSERVATION DIVISION
 Wichita, Kansas

SUBSCRIBED AND SWORN TO before me this 18th day of April, 19 83

[Signature: Bettye Jean Davis]

My Commission Expires: 2/06/85