


STATE OF KANSAS
STATE CORPORATION COMMISSION

Give All Information Completely
Make Required Affidavit
Mail or Deliver Report to:
Conservation Division
State Corporation Commission

WELL PLUGGING RECORD

P. O. Box 17027
Wichita, Kansas 67217
NORTH

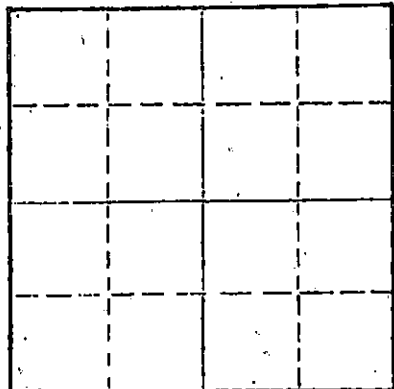

Locate well correctly on above
Section Plat

Kiowa County, Sec. 3 Twp. 28S Rge. (E) 19 (W)
Location as "NE/CNW&SW" or footage from lines. SW SW NW
Lease Owner THORNTON E. ANDERSON
Lease Name Miller Well No. 1
Office Address 300 W. Douglas, Suite 340, Wichita, Ks.
Character of Well (completed as Oil, Gas or Dry Hole) Dry Hole
Date well completed 4-4 19 74
Application for plugging filed 4-4 19 74
Application for plugging approved 4-4 19 74
Plugging commenced 4-4 19 74
Plugging completed 4-4 19 74
Reason for abandonment of well or producing formation No commercial quantities of oil or gas encountered.
If a producing well is abandoned, date of last production 19
Was permission obtained from the Conservation Division or its agents before plugging was commenced? Yes

Name of Conservation Agent who supervised plugging of this well G.R. Boberstein
Producing formation Depth to top Bottom Total Depth of Well 4873 Feet
Show depth and thickness of all water, oil and gas formations.

OIL, GAS OR WATER RECORDS

CASING RECORD

FORMATION	CONTENT	FROM	TO	SIZE	PUT IN	PULLED OUT
Surface Hole	Water	Surface	417	8-5/8"	409'	None

Describe in detail the manner in which the well was plugged, indicating where the mud fluid was placed and the method or methods used in introducing it into the hole. If cement or other plugs were used, state the character of same and depth placed, from feet to feet for each plug set.

Fluid to 350', plug, 40 sx cement;
Fluid to 40', plug, 15 sx cement
Two sacks cement in rat hole.

RECEIVED
STATE CORPORATION COMMISSION
APR 11 1974
CONSERVATION DIVISION
Wichita, Kansas

(If additional description is necessary, use BACK of this sheet)
Name of Plugging Contractor D N B DRILLING, INC.
Address 701 First Nat'l Bldg., Wichita, Kansas 67202

STATE OF KANSAS, COUNTY OF ss.
JAMES L. DONELSON (employee of owner) or (owner or operator) of the above-described well, being first duly sworn on oath, says: That I have knowledge of the facts, statements, and matters herein contained and the log of the above-described well as filed and that the same are true and correct. So help me God.

(Signature) *James L. Donelson*
701 First Nat'l Bldg., Wichita, Ks.
(Address)

SUBSCRIBED AND SWORN to before me this 10th day of April, 19 74

My commission expires August 25, 1976

Ella Priess
Ella Priess Notary Public.
STATE NOTARY PUBLIC
Sedgwick County, Kansas
My Com. Expires Aug. 25, 1976

DRILLERS' LOG

THORNTON E. ANDERSON
No. 1 Miller
SW SW NW, Sec. 3-28S-19W
Kiowa County, Kansas

Elevation: 2263 K.B.

Commenced: 3-25-74
Completed: 4-4-74

Surface Casing: 409' of
8-5/8" cemented w/300 sx
common cement, 2% Gel, 3% cc.
3-26-74

<u>FORMATION</u>	<u>DEPTH</u>
Surface Hole	0 - 417
Shale & Shells	417 - 622
Blaine Anhydrite	622 - 639
Shale and Sand	639 - 1165
Red Bed & Sand Streaks	1165 - 1205
Stone Corral Anhy.	1205 - 1235
Shale	1235 - 1730
Shale & Lime	1730 - 2300
Lime & Shale	2300 - 3615
Lime	3615 - 4873 T.D

RECEIVED
STATE CORPORATION COMMISSION
APR 11 1974
CONSERVATION DIVISION
Wichita, Kansas

I do hereby certify that the foregoing statements are true and correct to the best of my knowledge and belief.

D N B DRILLING, INC.

James L. Donelson
JAMES L. DONELSON

STATE OF KANSAS: ss:

Subscribed and sworn to before me, the undersigned, a Notary Public in and for said state, this 10th day of April, 1974.

My Commission Expires:
August 25, 1976

Ella Priess
Ella Priess, Notary Public

Ella Priess
STATE NOTARY PUBLIC
Sedgwick County, Kansas
My Com. Expires Aug. 25, 1976