


STATE OF KANSAS
STATE CORPORATION COMMISSION

Give All Information Completely
Make Required Affidavit
Mail or Deliver Report to:
Conservation Division
State Corporation Commission
212 No. Market
Wichita, Kansas

15-097-30082-00-01
Form CP-4

WELL PLUGGING RECORD

NORTH

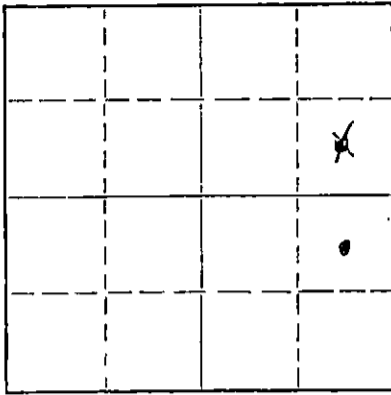

Locate well correctly on above
Section Plat

Kiowa County, Sec. 2 Twp. 28S Rge. 19 (E) (W) X
Location as "NE/CNW/SW" or footage from lines NE SE
Lease Owner Woods Petroleum Corporation
Lease Name Pyle Well No. 2
Office Address Oklahoma City, Oklahoma
Character of Well (completed as Oil, Gas or Dry Hole) Oil
Date well completed 1-8-65 19 65
Application for plugging filed MARCH 15, 19 68
Application for plugging approved MARCH 15, 19 68
Plugging commenced 3-27-68 19 68
Plugging completed 3-30-68 19 68
Reason for abandonment of well or producing formation _____

If a producing well is abandoned, date of last production Depleted Feb 1968
Was permission obtained from the Conservation Division or its agents before plugging was commenced? Yes

Name of Conservation Agent who supervised plugging of this well Herman Justice
Producing formation Mississippi Depth to top 4853 Bottom 4896 Total Depth of Well 4902 Feet
Show depth and thickness of all water, oil and gas formations.

OIL, GAS OR WATER RECORDS

CASING RECORD

FORMATION	CONTENT	FROM	TO	SIZE	PUT IN	PULLED OUT
<u>Mississippi</u>	<u>Oil</u>	<u>4853</u>	<u>4896</u>	<u>8 5/8</u>	<u>361</u>	<u>None</u>
				<u>4 1/2</u>	<u>None</u>	<u>2912</u>
					<u>4918'</u>	

Describe in detail the manner in which the well was plugged, indicating where the mud fluid was placed and the method or methods used in introducing it into the hole. If cement or other plugs were used, state the character of same and depth placed, from _____ feet to _____ feet for each plug set.

Moved in unit. Cleaned out cellar.

Sanded to 4800'. Dumped 4 sacks of cement. Rigged up unit. Working pipe. Shot pipe at 2930'.

Working pipe. Pulling pipe.

Bailed hole to 350' rock bridge. Dumped 25 sacks of cement. Filled hole and rock bridge. Capped well with 10 sacks of cement. Cleaned and doped collar threads. Put on pector.

RECEIVED
STATE CORPORATION COMMISSION
APR 3 1968
CONSERVATION DIVISION
Wichita, Kansas

(If additional description is necessary, use BACK of this sheet)
Name of Plugging Contractor Forbes Casing Pulling, Inc.
Address P. O. Box 221 Great Bend, Kansas

STATE OF Kansas, COUNTY OF Barton, ss.
J. O. Forbes (employee of owner) or (owner or operator) of the above-described well, being first duly sworn on oath, says: That I have knowledge of the facts, statements, and matters herein contained and the log of the above-described well as filed and that the same are true and correct. So help me God.

(Signature) J. O. Forbes
P. O. Box 221 Great Bend, Kansas
(Address)

SUBSCRIBED AND SWORN TO before me this 1 day of April, 19 68

My commission expires May 27, 1969 Notary Public.