

WELL PLUGGING RECORD

Give All Information Completely
Make Required Affidavit
Mail or Deliver Report to:
Conservation Division
State Corporation Commission
800 Biting Building
Wichita, Kansas

KIOWA County, Sec. 2 Twp. 28S Rge. (E) 19 (W)

Location as "NE/CNW/SW" or footage from lines NW NW SE

Lease Owner FALCON SEABOARD DRILLING COMPANY

Lease Name PYLE-TAYLOR Well No. 1

Office Address STANOLIND BUILDING, TULSA, OKLAHOMA

Character of Well (completed as Oil, Gas or Dry Hole) DRY HOLE

Date well completed SEPTEMBER 7, 19 55

Application for plugging filed SEPTEMBER 7, 19 55

Application for plugging approved SEPTEMBER 12, 19 55


Plugging commenced SEPTEMBER 8, 19 55

Plugging completed SEPTEMBER 8, 19 55

Reason for abandonment of well or producing formation

If a producing well is abandoned, date of last production 19

Was permission obtained from the Conservation Division or its agents before plugging was commenced? YES

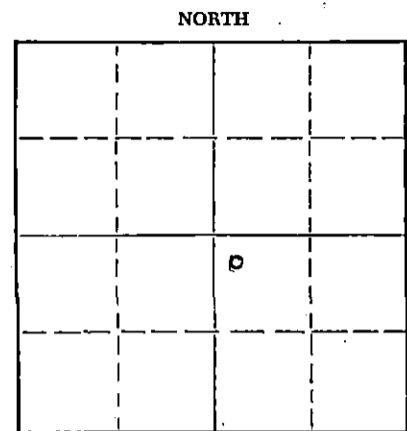

Locate well correctly on above Section Plat

Name of Conservation Agent who supervised plugging of this well M. A. RIVES

Producing formation Depth to top Bottom Total Depth of Well 5395 Feet

Show depth and thickness of all water, oil and gas formations.

OIL, GAS OR WATER RECORDS

CASING RECORD

FORMATION	CONTENT	FROM	TO	SIZE	PUT IN	PULLED OUT
				9 5/8	333	NONE

Describe in detail the manner in which the well was plugged, indicating where the mud fluid was placed and the method or methods used in introducing it into the hole. If cement or other plugs were used, state the character of same and depth placed, from feet to feet for each plug set.

HOLE WAS FULL OF MUD. SET PLUG WITH 35 SACKS AT 300'. SET 2ND PLUG WITH 15 SACKS TO TOP OF SURFACE CASING.

(If additional description is necessary, use BACK of this sheet)

Name of Plugging Contractor FALCON SEABOARD DRILLING COMPANY

Address STANOLIND BUILDING, TULSA, OKLAHOMA

STATE OF OKLAHOMA, COUNTY OF TULSA, ss.

J. O. BROWN (employee of owner) or (owner or operator) of the above-described well, being first duly sworn on oath, says: That I have knowledge of the facts, statements, and matters herein contained and the log of the above-described well as filed and that the same are true and correct. So help me God.

(Signature) J. O. Brown

Stanolind Bldg - Tulsa, Okla (Address)

SUBSCRIBED AND SWORN TO before me this 17TH day of OCTOBER, 19 55

My commission expires Feb 8, 1958

Notary Public, STATE CORPORATION COMMISSION

PLUGGING
FILE SEC 2 T28 R19W
BOOK PAGE 148 LINE 44

OCT 19 1955
CONSERVATION DIVISION
Wichita, Kansas

10-19-55

WELL LOG

15-097-01005-0000

COMPANY - Falcon Seaboard Drilling Company

Sec. 2-28S-19W

FARM - Pyle-Taylor No. 1

Loc. NW NW SE

TOTAL DEPTH - 5,395'

COMM. - 8-12-55 COMP. 9- 7-55

CONTRACTOR - Company Tools.

ELEVATION

D.F. - 2285

Gr. - 2280

CASING

9 5/8" - 333'

DRILLER'S LOG

Surface Soil, Gravel & Red Bed	0	315
Shale	315	2054
Shale & Lime	2054	2769
Shale	2769	2821
Shale & Lime	2821	3012
Shale	3012	3579
Shale & Lime	3579	4203
Shale	4203	4337
Shale & Lime	4337	4724
Sand & Shale	4724	4752
Shale	4752	4820
Shale & Lime	4820	5029
Sand & Shale	5029	5051
Chert, Lime & Shale	5051	5080
Shale & Lime	5080	5137
Shale, Chert & Lime	5137	5167
Shale & Lime	5167	5220
Lime & Chert	5220	5251
Shale & Lime	5251	5284
Sandy Lime	5284	5316
Shells & Lime	5316	5341
Shale & Lime	5341	5395
<u>TOTAL DEPTH</u>	5395	

RECORDED
 STATE CORPORATION COMMISSION
 OCT 19 1955
 CONSERVATION DIVISION
 Wichita, Kansas

PLUGGING
 FILE SEC-2 T28 R19W
 BOOK PAGE 42 LINE 44