


15-097-20518-0000

STATE OF KANSAS
STATE CORPORATION COMMISSION

WELL PLUGGING RECORD

Give All Information Completely
Make Required Affidavit
Mail or Deliver Report to
Conservation Division
State Corporation Comm.
245 North Water
Wichita, KS 67202

Kiowa County, Sec. 2 Twp. 28S Rge. 19W E/W
Location as "NE/CNW $\frac{1}{4}$ SW $\frac{1}{4}$ " or footage from lines
C S/2 SE SE
Lease Owner TGT Petroleum Corporation
Lease Name Pyle "A" #2 Well No. 2
Office Address 209 E. William, Wichita, Kansas 67202
Character of Well (Completed as Oil, Gas or Dry Hole)
Dry Hole

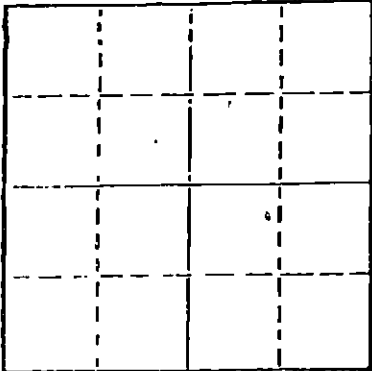

Locate well correctly on above
Section Plat

Date Well completed Feb. 10 19 79
Application for plugging filed (verbally) Feb. 10 19 79
Application for plugging approved (verbally) Feb. 10 19 79
Plugging commenced Feb. 10 19 79
Plugging completed Feb. 10 19 79
Reason for abandonment of well or producing formation
No commercial quantity of oil or gas encountered.
If a producing well is abandoned, date of last production
19

Was permission obtained from the Conservation Division or
its agents before plugging was commenced? Yes

Name of Conservation Agent who supervised plugging of this well Bill Owens
Producing formation _____ Depth to top _____ Bottom _____ Total Depth of Well 5070'
Show depth and thickness of all water, oil and gas formations.

OIL, GAS OR WATER RECORDS

CASING RECORD

FORMATION	CONTENT	FROM	TO	SIZE	PUT IN	PULLED OUT

Describe in detail the manner in which the well was plugged, indicating where the mud fluid was placed and the method or methods used in introducing it into the hold. If cement or other plugs were used, state the character of same and depth placed, from _____ feet to _____ feet for each plug set.

T.D. 5070'
Set 1st plug at 600' with 50 sacks
2nd plug at 360' with 40 sacks
3rd plug at 40' with 12 $\frac{1}{2}$ sacks + $\frac{1}{2}$ sack hulls
rathole with 3 sacks.
Cemented with 50/50 posmix, 6% gel.
Plug was down at 6:30 a.m., 2-10-79

RECEIVED
STATE CORPORATION COMMISSION
FEB 26 1979
CONSERVATION DIVISION
Wichita, Kansas

2-26-79

(If additional description is necessary, use BACK of this sheet)

Name of Plugging Contractor Abercrombie Drilling, Inc.

STATE OF Kansas COUNTY OF Sedgwick, ss.
Jack L. Partridge, Asst. Sec.-Treas. (employee of owner) or (owner or operator)
of the above-described well, being first duly sworn on oath, says: That I have knowledge of
the facts, statements, and matters herein contained and the log of the above-described well
as filed and that the same are true and correct. So help me God.



(Signature) Jack L. Partridge
801 Union Center, Wichita, Kansas 67202
(Address)

SUBSCRIBED AND SWORN TO before me this 23rd day of February, 19 79

Sherrie L. Brooks
Sherrie L. Brooks Notary Public.

My commission expires 8-21-82

CONTRACTOR'S WELL LOG

15-097-70518-0000

OPERATOR: TGT Petroleum Corporation
 CONTRACTOR: Abercrombie Drilling, Inc.
 WELL NAME: PYLE "A" #2
 LOCATION: C S/2 SE SE, Section 2-28S-19W
 Kiowa County, Kansas
 SPUD DATE: January 26, 1979
 COMPLETION DATE: February 10, 1979

0	203	Sand
203	430	Red bed and shale
430	1220	Red bed and shale
1220	1855	Shale and limey shale
1855	2385	Shale and lime
2385	4764	Lime and shale
4764	4805	Lime, shale and chert
4805	5070	Lime and shale
	5070	Rotary Total Depth

Spud hole at 11:00 a.m., January 26, 1979. Drilled 367' of 12 1/4" hole. Ran 9 joints of new 8-5/8" - 20# casing. Set at 367' with 300 sacks of posmix, 3% Ca.Cl. Cement did circulate. Ran texas guide shoe centralizer on bottom ran basket at 200' centralizer on each side. Plug was down at 9:15 p.m. on January 26, 1979.

T.D. 5070'. Set 1st plug at 600' with 50 sacks, 2nd plug at 360' with 40 sacks, 3rd plug at 40' with 12 1/2 sacks + 1/2 sack hulls, rathole with 3 sacks. Cemented with 50/50 posmix, 6% gel. Plug was down at 6:30 a.m., February 10, 1979.

SAMPLE TOPS:

Anhydrite 1192'
 B/Anhydrite 1214'

RECEIVED
 STATE CORPORATIONS COMMISSION

FEB 26 1979

CONSERVATION DIVISION
 Wichita, Kansas


STATE OF KANSAS)
) ss
 COUNTY OF SEDGWICK)

Jack L. Partridge, Assistant Secretary-Treasurer of Abercrombie Drilling, Inc., does hereby state that the above and foregoing is a true and correct copy of the log of the Pyle "A" #2, C S/2 SE SE, Section 2-28S-19W, Kiowa County, Kansas.

ABERCROMBIE DRILLING, INC.

BY Jack L. Partridge
 Jack L. Partridge
 Assistant Secretary-Treasurer

Subscribed and sworn to before me, a Notary Public, in and for the county and state aforesaid, as of this 23rd day of February, 1979.

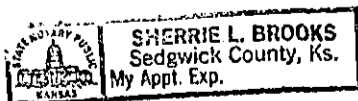

Sherrie L. Brooks
 Sherrie Brooks, Notary Public

My commission expires 8-21-82.