

STATE OF KANSAS
STATE CORPORATION COMMISSION
130 S. Market, Room 2078
Wichita, KS 67202

WELL PLUGGING RECORD
K.A.R.-82-3-117

API NUMBER 15-057-20,896-0000

LEASE NAME Moore "U"

TYPE OR PRINT
NOTICE: Fill out completely
and return to Cons. Div.
office within 30 days.

WELL NUMBER 3

 Ft. from S Section Line

 Ft. from E Section Line

LEASE OPERATOR Pickrell Drilling Co., Inc.

SEC. 32 TWP. 29S RGE. 24W (E) or (W)

ADDRESS 110 N. Market, #205 Wichita, KS 67202

COUNTY Ford

PHONE (316) 262-8427 OPERATORS LICENSE NO. 5123

Date Well Completed

Character of Well Oil

Plugging Commenced 10-31-96

(Oil, Gas, O&A, SWD, Input, Water Supply Well)

Plugging Completed 11-04-96

The plugging proposal was approved on (date)

by (KCC District Agent's Name).

Is ACO-1 filed? If not, is well log attached?

Producing Formation Depth to Top Bottom T.D. 5471'

Show depth and thickness of all water, oil and gas formations.

OIL, GAS OR WATER RECORDS | CASING RECORD

Formation	Content	From	To	Size	Put In	Pulled out
				8 5/8	520'	none
				4 1/2	5460'	2618'

Describe in detail the manner in which the well was plugged, indicating where the mud fluid placed and the method or methods used in introducing it into the hole. If cement or other plugging materials were used, state the character of same and depth placed, from feet to feet each section. Plugged off bottom with sand to 5225' & 5 sks cement. Shot at 4000', 3510', 3028', 2805', 2618'. Pipe came loose at 2618'. Pulled to 1510', pumped 10 sks gel, 50 sks cement, 5 sks gel at 1510'. Pulled to 550', pumped 50 sks cement. Pulled rest of pipe & topped with 10 sks. Plugging complete. 60/40 6%.

Name of Plugging Contractor Mike's Testing & Salvage, Inc. License No. 31529

Address P.O. Box 467 Chase, Kansas 67524

NAME OF PARTY RESPONSIBLE FOR PLUGGING FEES: Pickrell Drilling Co., Inc.

STATE OF Kansas COUNTY OF Rice, ss.

Mike Kelso (Employee of Operator) or (Operator) above-described well, being first duly sworn on oath, says: That I have knowledge of the facts and matters herein contained and the log of the above-described well as filed to the same are true and correct, so help me God.

(Signature) *Mike Kelso*

(Address) P. O. Box 467 Chase, KS 67524

SUBSCRIBED AND SWORN TO before me this 12th day of November, 19 96

Irene Henzberg
Notary Public

My Commission Expires:




11-13-96

RECEIVED
KANSAS CORP COM
NOV 13 4 11 PM '96

New Completion Workover

Oil Company _____ Well No. 3 Field _____ Lease Moore U
Company Man _____ Date Drilled 12/84 County Ford State Kansas

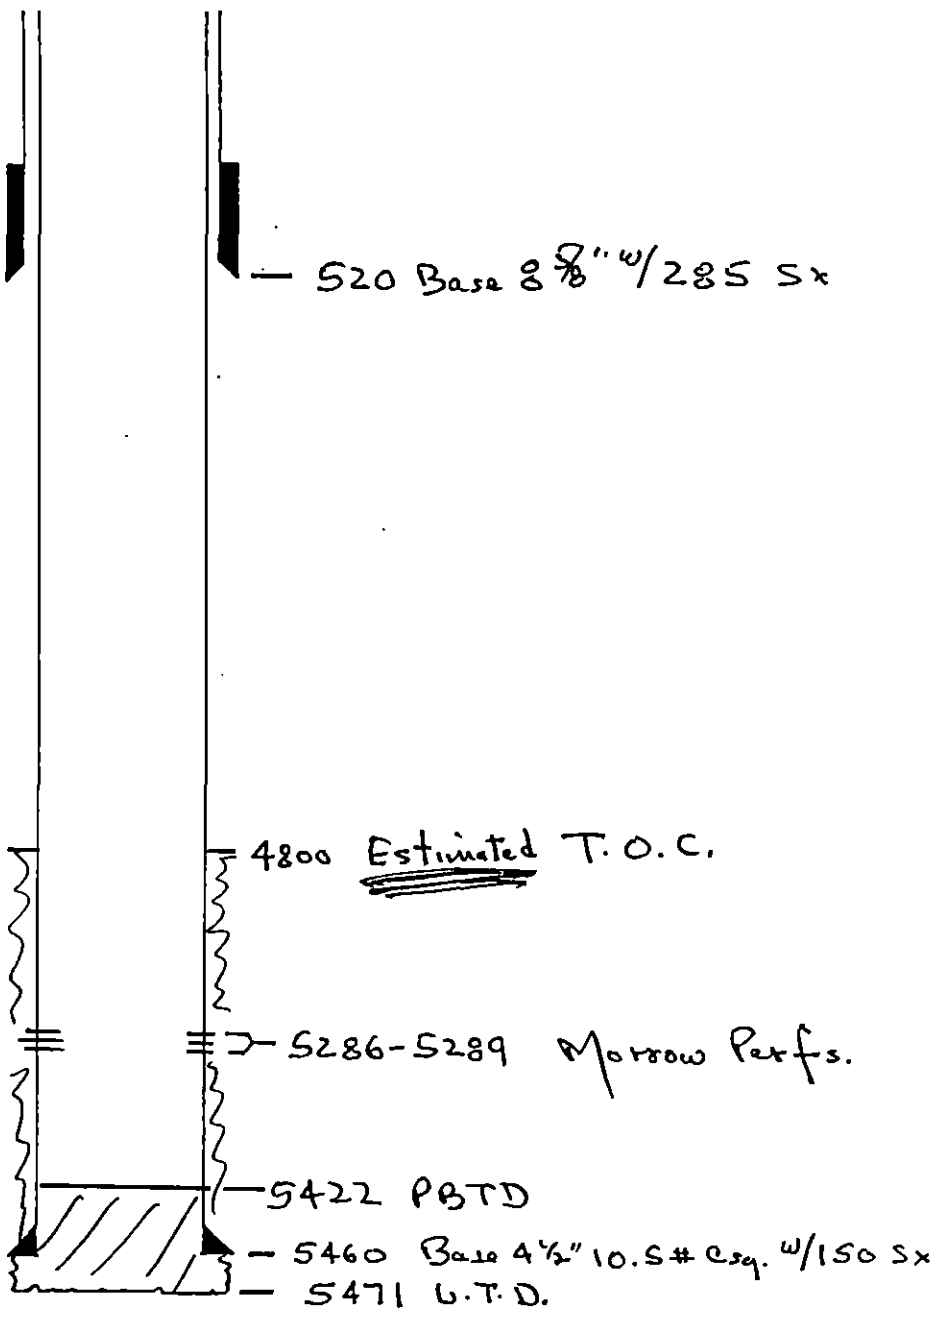

REMARKS: _____

RECEIVED
STATE CORPORATION COMMISSION

SEP 13 1996

COMMERCIAL KANSAS



DUAL INDUCTION-SFL W/GR

CSU Field Log

15-057-20396-000

COMPANY: PICKRELL DRILLING COMPANY
 WELL: MOORE U-3
 FIELD:
 COUNTY: FORD
 STATE: KANSAS
 NATION: USA
 LOCATION: SW SW SW
 SEC: 32 TWP: 29S RGE: 24W

PERMANENT DATUM: GL ELEVATIONS-
 ELEV. OF PERM. DATUM: 2564.0 F KB: 2569.0 F
 LOG MEASURED FROM: KB DF: 2567.0 F
 5.0 F ABOVE PERM. DATUM GL: 2564.0 F
 DRLG. MEASURED FROM: KB

DATE: 19 DEC 84
 RUN NO: 1

DEPTH-DRILLER: 5470.0 F
 DEPTH-LOGGER: 5471.0 F
 BTM. LOG INTERVAL: 5465.0 F
 TOP LOG INTERVAL: 519.0 F
 CASING-DRILLER: 515 F
 CASING-LOGGER: 519 F
 CASING: 8 5/8"
 BIT SIZE: 7 7/8"
 DEPTH: 5470 F

BEFORE	AFTER	BEFORE	AFTER	UNITS
ILD 0.0	.0	499.8	495.3	MMHD
ILM 0.0	.0	500.0	494.4	MMHD
SFL 0.0	-.0	500.0	492.3	MMHD
				RECEIVED
ILD SONDE ERROR CORRECTION :		3.9	MMHD	
ILM SONDE ERROR CORRECTION :		6.3	MMHD	

STATE CORPORATION COMMISSION

SEP 13 1996

FILE 6 19-DEC-84 13:35

GR (GAPI)	300.00		
150.00		ILD (OHMM)	50.000
		SFLA(OHMM)	50.000
GR (GAPI)	150.00		
0.0			
SP (MY)	30.000		
-120.0			
			CILD(MMHD)
			1000.0
			0.0

FILE 4 19-DEC-84 13:33

