

16.

TYPE OR PRINT
NOTICE: Fill out completely
and return to Cons. Div.
office within 30 days.

LEASE NAME Moore U

WELL NUMBER #1

330 Ft. from S Section Line

3300 Ft. from E Section Line

SEC. 32 TWP. 29S RGE. 24W (E) or (W)

COUNTY Ford

Date Well Completed 6-83

Plugging Commenced 10-31-94

Plugging Completed 11-3-94

LEASE OPERATOR Pickrell Drilling Co., Inc.

ADDRESS 110 N. Market, Suite 205

PHONE# (316) 262-8427 OPERATORS LICENSE NO. 5123

Character of Well Gas

(Oil, Gas, D&A, SWD, Input, Water Supply Well)

The plugging proposal was approved on 10-94 (date)

by David P. Williams (KCC District Agent's Name).

Is ACO-1 filed? Yes If not, is well log attached? _____

Producing Formation Morrow Depth to Top 5276' Bottom 5282' T.D. 5326'

Show depth and thickness of all water, oil and gas formations.

OIL, GAS OR WATER RECORDS

CASING RECORD

Formation	Content Gas	From GL	To	Size	Put in	Pulled out
Morrow			531	8 5/8	531	None
				4 1/2"	5374'	2750'

Describe in detail the manner in which the well was plugged, indicating where the mud fluid was placed and the method or methods used in introducing it into the hole. If cement or other plugs were used, state the character of same and depth placed, from _____ feet to _____ feet each set. Spot sand to 50' above perfs with 4 sks cement on top of sand. Cut casing at 2750'. Pulled all casing. Had Allied Cementing plug well as follows. Pump 300 lbs hulls, 10sks Gel, 50sks cement, 10sks Gel, 100lbs hulls, 8 5/8" wiper plug and 150sks cement. All cement being 60/40 6%.

(If additional description is necessary, use BACK of this form.)

Name of Plugging Contractor Peters Drilling Co., Inc. License No. 03400

Address PO Box 742 Great Bend, Ks.


NAME OF PARTY RESPONSIBLE FOR PLUGGING FEES: Pickrell Drilling Co., Inc.

STATE OF Kansas COUNTY OF Sedgwick, ss.

Michael J. Peters (Employee of Operator) or (Operator) of above-described well, being first duly sworn on oath, says: That I have knowledge of the facts, statements, and matters herein contained and the log of the above-described well as filed that the same are true and correct, so help me God.

(Signature) Michael J. Peters

(Address) _____

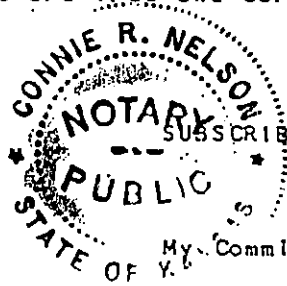

SUBSCRIBED AND SWORN TO before me this 4th day of November, 19 94

Connie R. Nelson Notary Public

My Commission Expires: 11-11-94

RECEIVED
STATE CORPORATION COMMISSION
JAN 24 1995
UNIVERSITY DIVISION
WICHITA, KANSAS

New Completion Workover

Oil Company _____

Well No. 1

Field _____


Lease Moore U

Company Man _____

Date Drilled 6/83

County Ford

State Kansas

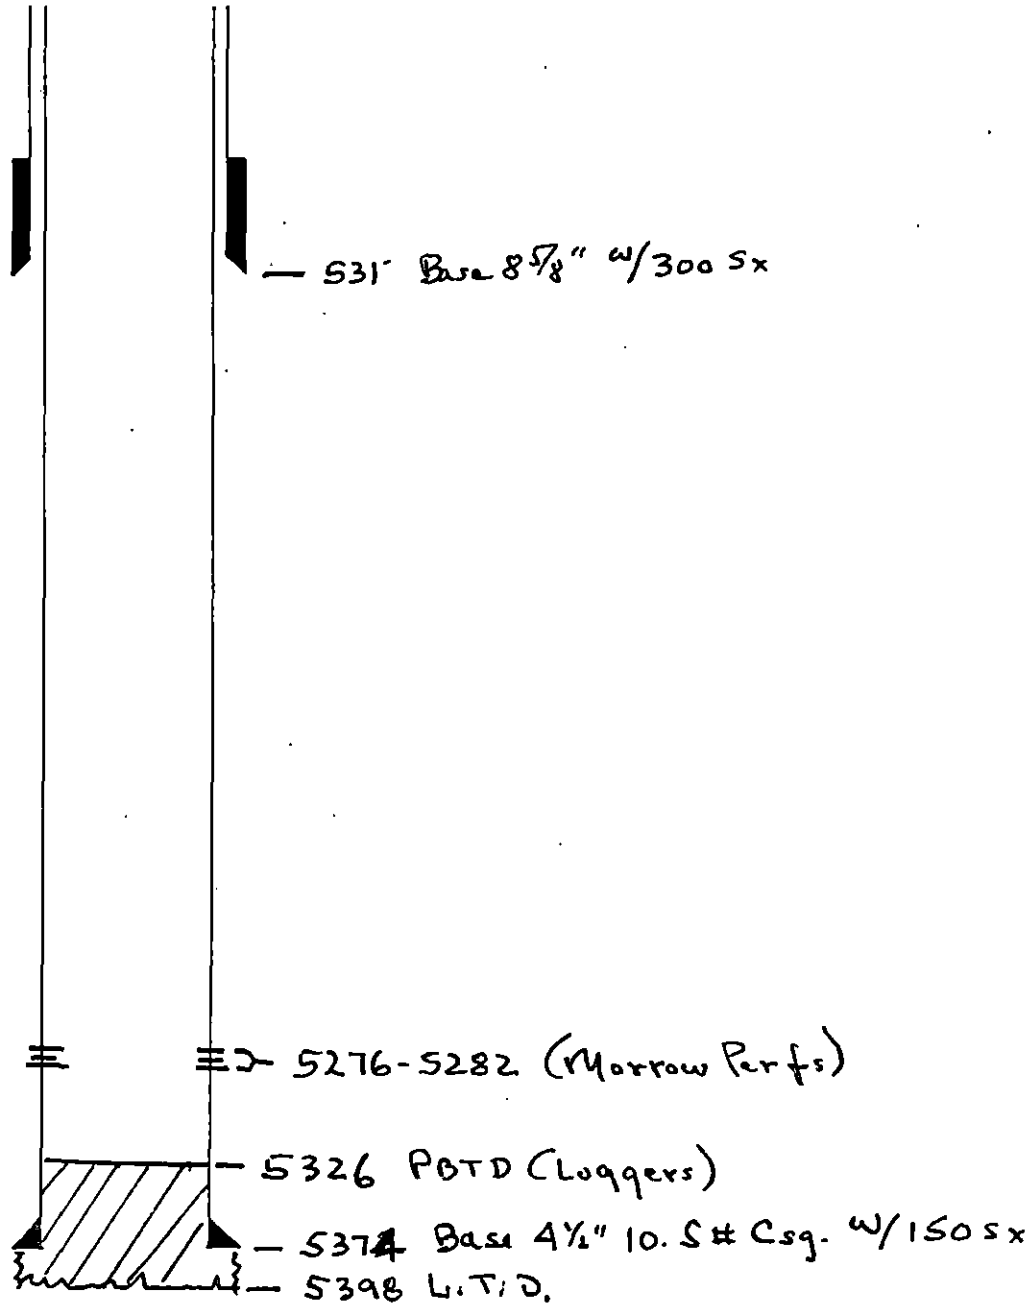

REMARKS: _____

