


STATE OF KANSAS
STATE CORPORATION COMMISSION

WELL PLUGGING RECORD

Give All Information Completely
Make Required Affidavit
Mail or Deliver Report to
Conservation Division
State Corporation Comm.
245 North Water
Wichita, KS 67202

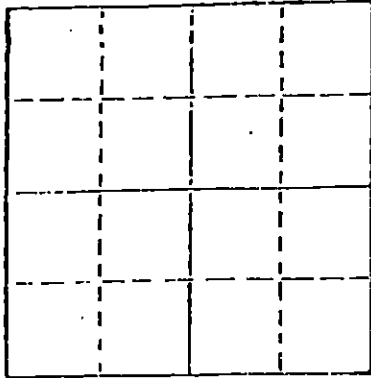

Locate well correctly on above
Section Plat

Ford County. Sec. 26 Twp. 29S Rge. 24 NE/W
Location as "NE/CNW $\frac{1}{4}$ SW $\frac{1}{4}$ " or footage from lines
C W/2 W/2 SW

Lease Owner Ladd Petroleum Corporation
Lease Name W. A. Weddle Well No. #1

Office Address Box 2848 - 522 South Boston, Tulsa, Okla.
Character of Well (Completed as Oil, Gas or Dry Hole) Dry Hole

Date Well completed 6-14-81 19
Application for plugging filed 6-13-81 19
Application for plugging approved 6-13-81 19
Plugging commenced 6-13-81 19
Plugging completed 6-14-81 19
Reason for abandonment of well or producing formation Commercial quantities of oil not found

If a producing well is abandoned, date of last production 19

Was permission obtained from the Conservation Division or its agents before plugging was commenced? Yes

Name of Conservation Agent who supervised plugging of this well Clarence Thomas
Producing formation _____ Depth to top _____ Bottom _____ Total Depth of Well 3305'
Show depth and thickness of all water, oil and gas formations.

OIL, GAS OR WATER RECORDS

CASING RECORD

FORMATION	CONTENT	FROM	TO	SIZE	PUT IN	PULLED OUT
				8 5/8"	770'	None

Describe in detail the manner in which the well was plugged, indicating where the mud fluid was placed and the method or methods used in introducing it into the hold. If cement or other plugs were used, state the character of same and depth placed, from _____ feet to _____ feet for each plug set.

Plug @ 1100' w/35 sx.
Plug @ 600' w/50 sx.
Plug @ 40' w/10 sx.
Rat Hole .5 sx.
Mouse Hole 5 sx.

Feed 629-81

(If additional description is necessary, use BACK of this sheet)

Name of Plugging Contractor Rains & Williamson Oil Co., Inc.

STATE OF Kansas COUNTY OF Sedgwick, ss.
Wilson Rains, President of Rains & Williamson Oil Co., (Employee of owner) or (owner or operator) of the above-described well, being first duly sworn on oath, says: That I have knowledge of the facts, statements, and matters herein contained and the log of the above-described well as filed and that the same are true and correct. So help me God.

(Signature) Wilson Rains
435 Page Court, 220 W. Douglas, Wichita, Ks. 67202
(Address)

SUBSCRIBED AND SWORN TO before me this 16 day of June, 19 81



Juanita M. Green
Notary Public.

DRILLER'S LOG

COMPANY: Ladd Petroleum Corporation

SEC. 26 T. 29S R. 24W

WELL NAME: W. A. Weddle #1

LOC. C W/2 W/2 SW

COUNTY: Ford

RIG NO. #5

TOTAL DEPTH 3305'

ELEVATION

COMMENCED: 6-6-81

COMPLETED: 6-14-81

CONTRACTOR: Rains & Williamson Oil Co., Inc.

CASING RECORD:

SURFACE: 8 5/8" @ 770' w/300 sx. HL, 2% cc. and 150 sx. Class H, 3% cc.

PRODUCTION: D&A

LOG

(Figures Indicate Bottom of Formations)

Sand	775
Sand & Redbed	1081
Redbed	1809
Shale & Redbed	2493
Shale	2687
Shale & Lime	2951
Lime & Shale	3108
Shale & Lime	3243
Lime & Shale	3305
<u>ROTARY TOTAL DEPTH</u>	<u>3305</u>

RECEIVED
STATE CORPORATION COMMISSION

JUN 29 1981

CONSERVATION DIVISION
Wichita, Kansas

STATE OF Kansas)

COUNTY OF Sedgwick)

SS:

I, Wilson Rains, President of Rains & Williamson Oil Co., Inc.

upon oath state that the above and foregoing is a true and correct copy of the log of the
W. A. Weddle #1 well.

Wilson Rains
Wilson Rains

Subscribed and sworn to before me this 16 day of June, 1981.

My Appointment Expires:
10-4-83

Juanita M. Green
Juanita M. Green

