


STATE OF KANSAS  
STATE CORPORATION COMMISSION

WELL PLUGGING RECORD

Give All Information Completely  
Make Required Affidavit  
Mail or Deliver Report to  
Conservation Division  
State Corporation Comm.  
245 North Water  
Wichita, KS 67202

Ford County, Sec. 13 Twp. 29S Rge. 23W E/W  
Location as "NE/CNW $\frac{1}{4}$ SW $\frac{1}{4}$ " or footage from lines  
C SW

Lease Owner Pickrell Drilling Company  
Lease Name Cummings C Well No. #1  
Office Address 205 Litwin Bldg., Wichita, Kansas 67202  
Character of Well (Completed as Oil, Gas or Dry Hole)  
DRY HOLE

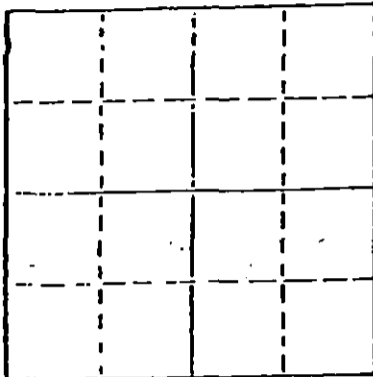

Locate well correctly on above  
Section Plot

Date Well completed 8-1-80 19  
Application for plugging filed 8-1-80 19  
Application for plugging approved 8-1-80 19  
Plugging commenced 8-1-80 19  
Plugging completed 8-1-80 19  
Reason for abandonment of well or producing formation  
DRY HOLE

If a producing well is abandoned, date of last production 19

Was permission obtained from the Conservation Division or  
its agents before plugging was commenced? Yes

Name of Conservation Agent who supervised plugging of this well Clarence Thomas Jr.  
Producing formation Depth to top Bottom Total Depth of Well 5500  
Show depth and thickness of all water, oil and gas formations.

OIL, GAS OR WATER RECORDS

CASING RECORD

| FORMATION | CONTENT | FROM | TO | SIZE  | PUT IN | PULLED OUT |
|-----------|---------|------|----|-------|--------|------------|
|           |         |      |    | 8 1/2 | 324'   | NONE       |
|           |         |      |    |       |        |            |
|           |         |      |    |       |        |            |

Describe in detail the manner in which the well was plugged, indicating where the mud fluid  
was placed and the method or methods used in introducing it into the hold. If cement or other  
plugs were used, state the character of same and depth placed, from \_\_\_\_\_ feet to  
\_\_\_\_\_ feet for each plug set.

.60 sx at 350'  
10 sx at 40' with solid bridge plug  
5.sx rathole Comp. 3:30 AM on 8-1-80

RECEIVED  
STATE CORPORATION COMMISSION  
AUG 11 1980

(If additional description is necessary, use BACK of this sheet)

Name of Plugging Contractor PICKRELL DRILLING COMPANY  
Wichita, Kansas

STATE OF KANSAS COUNTY OF SEDGWICK, ss.  
C.W. Sebitts (employee of owner) or (owner or operator)


of the above-described well, being first duly sworn on oath, says: That I have knowledge of  
the facts, statements, and matters herein contained and the log of the above-described well  
as filed and that the same are true and correct. So help me God.

BY: C.W. Sebitts  
(Signature) *C.W. Sebitts*  
205 Litwin Bldg., Wichita, Kansas 67202  
(Address)

SUBSCRIBED AND SWORN TO before me this 7 day of August, 19 80

*Brenda A. Baldwin*  
Brenda A. Baldwin, Notary Public.

My commission expires June 24, 1982

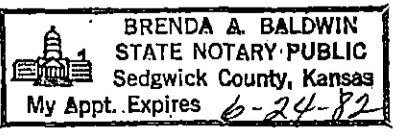

ROTARY DRILLING LOG

COMPANY: PICKRELL DRILLING COMPANY  
205 LITWIN BLDG.  
WICHITA, KANSAS 67202  
LOCATION: #1 CUMMINGS 'C'  
C SW Sec. 13-29S-23W  
FORD COUNTY, KANSAS

Rotary Drilling Commenced 7-21-80  
Rotary Drilling Completed 8-1-80

CONTRACTOR: **PICKRELL DRILLING COMPANY**  
Wichita, Kansas

CASING RECORD: Spud date 7-21-80 Surf. Pipe 8 1/2" set at 324' KB with 200 sacks

LOG

(Figures indicate bottom of formation — measurements from top of rotary bushing.)

|              |      |
|--------------|------|
| Shale        | 614  |
| Shale        | 1235 |
| Shale        | 1890 |
| Shale & lime | 2255 |
| Lime & shale | 2570 |
| Lime & shale | 2740 |
| Lime & shale | 2930 |
| Lime & shale | 3135 |
| Lime & shale | 3300 |
| Lime & shale | 3530 |
| Lime & shale | 3725 |
| Lime & shale | 3915 |
| Lime & shale | 4220 |
| Lime & shale | 4415 |
| Lime & shale | 4590 |
| Lime & shale | 4750 |
| Lime & shale | 4922 |
| Lime & shale | 5030 |
| Lime & shale | 5155 |
| Lime & shale | 5221 |
| Lime         | 5221 |
| Lime         | 5243 |
| Lime & shale | 5307 |
| Lime & shale | 5390 |
| Lime         | 5500 |

RECEIVED  
STATE CORPORATION COMMISSION  
AUG 13 1980  
CONSERVATION DIVISION  
Wichita, Kansas

The undersigned, C.W. Sebitts, Attorney-in-Fact for PICKRELL DRILLING COMPANY, hereby certifies in behalf of said Company, that the above is a true and correct log of the formation encountered in drilling the above well as reflected by the Daily Drilling Reports.

PICKRELL DRILLING COMPANY  
By [Signature]  
Attorney-in-Fact  
C.W. Sebitts

BRENDA A. BALDWIN  
STATE NOTARY PUBLIC  
Sedgwick County, Kansas  
My Appt. Expires 6-24-82

STATE OF KANSAS }  
COUNTY OF SEDGWICK } ss.:

On this 7 day of August, 1980, before me the undersigned, a Notary Public, in and for Sedgwick County and State aforesaid, personally appeared C.W. Sebitts, to me known to be the identical person who subscribed the name of PICKRELL DRILLING COMPANY to the foregoing instrument as its Attorney-in-Fact and acknowledged to me that he executed the same as his free and voluntary act and deed, and as the free voluntary act and deed of such company, for the uses and purposes therein set forth.

Given under my hand and seal of office the day and year last above written.

[Signature]  
Notary Public  
Brenda A. Baldwin

My commission expires: June 24, 1982