

**NOTICE OF INTENTION TO DRILL**

(see rules on reverse side)

CARD MUST BE TYPED

CARD MUST BE SIGNED

Starting Date: July 20, 1985  
 month day year

API Number 15- 151-21,650-00-00

**OPERATOR:** License # 6408  
 Name W.K. BLACK, INC.  
 Address P.O. BOX 801  
 City/State/Zip PRATT, KANSAS 67124  
 Contact Person WILLIAM K. BLACK  
 Phone 316-672-5712

SE. NE SE/4 Sec 15 Twp 29 S, Rge 13  
 (location)  East  West

1650 Ft North from Southeast Corner of Section  
 330 Ft West from Southeast Corner of Section  
 (Note: Locate well on Section Plat on reverse side)

**CONTRACTOR:** License # 5107  
 Name H-30 DRILLING, INC.  
 City/State WICHITA, KANSAS

Nearest lease or unit boundary line 330 feet.  
 County Pratt

Lease Name Mason Well# 4-A

**Well Drilled For:** **Well Class:** **Type Equipment:**  
 Oil  Swd  Infield  Mud Rotary  
 Gas  Inj  Pool Ext.  Air Rotary  
 OWWO  Expl  Wildcat  Cable

Domestic well within 330 feet:  yes  no  
 Municipal well within one mile:  yes  no

If OWWO: old well info as follows:

Operator  
 Well Name  
 Comp Date Old Total Depth  
 Projected Total Depth 4800' feet  
 Projected Formation at TD Simpson, Arbuckle  
 Expected Producing Formations Marmaton, Simpson

Depth to Bottom of fresh water 200 feet  
 Lowest usable water formation  
 Depth to Bottom of usable water 250 feet  
 Surface pipe by Alternate: 1  2   
 Surface pipe to be set 375 feet  
 Conductor pipe if any required feet  
 Ground surface elevation 1870 (Approx.) feet MSL  
 This Authorization Expires 1-8-86

I certify that we will comply with K.S.A. 55-101, et seq., plus eventually plugging hole to K.C.E. specifications.

Date 7/5/85 Signature of Operator or Agent

*[Handwritten Signature]*

Approved By 7-8-85 *[Signature]*


RCH for KDHE

Must be filed with the K.C.C. five (5) days prior to commencing well  
 This card void if drilling not started within six (6) months of date received by K.C.C.

RECEIVED

Important procedures ~~STATE~~ CORPORATION COMMISSION

A Regular Section of Land  
 1 Mile = 5,280 Ft.

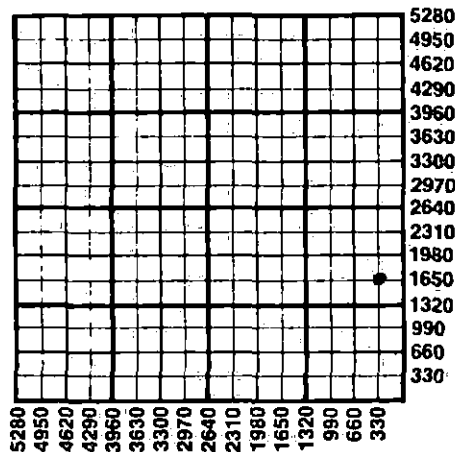

1. Notify District office before setting surface casing - 08 1985
2. Set surface casing by circulating cement to the top. 07-08-85
3. File completion forms ACO-1 with K.C.C. within 90 days of well completion, following instructions on ACO-1, side 1, and including copies of wireline logs. CONSERVATION DIVISION  
Wichita, Kansas
4. Notify District office 48 hours prior to old well workover or re-entry.
5. Prior to plugging, prepare a plugging plan, then obtain agreement from the appropriate district office for an approved plugging plan.
6. Submit plugging report (CP-4) to K.C.C. after plugging is completed.
7. Obtain an approved injection docket number before disposing of salt water.
8. Notify K.C.C. within 10 days when injection commences or terminates.
9. If an alternate 2 completion, cement in the production pipe from below any usable water to surface within 120 days of spud date.

State Corporation Commission of Kansas  
 Conservation Division  
 200 Colorado Derby Building  
 Wichita, Kansas 67202  
 (316) 263-3238