

CARD MUST BE TYPED

State of Kansas
NOTICE OF INTENTION TO DRILL
(see rules on reverse side)

CARD MUST BE SIGNED

Starting Date: December 6, 1984
month day year

API Number 15- 151-21524-0000

OPERATOR: License # 5234
Name Penguin Petroleum, Inc.
Address 1250 Kansas State Bank Bldg.
City/State/Zip Wichita, Kansas 67202
Contact Person W. C. Talbott
Phone 267-3393 (Bus.) 683-7057 (Res.)

110'W & 110'S of NE NE SE East
Sec. 6, Twp. 29S S, Rge 13W. West
(location)

2200' Ft North from Southeast Corner of Section
440' Ft West from Southeast Corner of Section
(Note: Locate well on Section Plat on reverse side)

CONTRACTOR: License # 5146
Name Rains & Williamson Oil Co., Inc.
City/State Wichita, Kansas 67202

Nearest lease or unit boundary line 440' feet.
County Pratt

Lease Name Leak Well# 1

Well Drilled For: Well Class: Type Equipment:
 Oil Swd Infield Mud Rotary
 Gas Inj Pool Ext. Air Rotary
 OWWO Expl Wildcat Cable

Domestic well within 330 feet: yes no
Municipal well within one mile: yes no

If OWWO: old well info as follows:

Operator
Well Name
Comp Date Old Total Depth
Projected Total Depth 4650' feet
Projected Formation at TD Arbuckle
Expected Producing Formations Simpson

Depth to Bottom of fresh water 250' feet
Lowest usable water formation Top of Permian
Depth to Bottom of usable water 250' feet
Surface pipe by Alternate: 1 2
Surface pipe to be set 250' + feet
Conductor pipe if any required No
Ground surface elevation Not Available feet MSL

This Authorization Expires 6-4-85
Approved By 12-4-84

I certify that we will comply with K.S.A. 55-101, et seq., plus eventually plugging hole to K.C.C. specifications.

Date 12-4-84 Signature of Operator or Agent W.C. Talbott Title PRESIDENT

MHC/KDHE 12/4/84 Form C-1 4/84


Must be filed with the K.C.C. five (5) days prior to commencing well
This card void if drilling not started within six (6) months of date received by K.C.C.

RECEIVED
WICHITA, KANSAS
CONSERVATION DIVISION

DEC 4 1984

RECEIVED
STATE CORPORATION COMMISSION
1 Mile
4-10-84

A Regular Section of Land

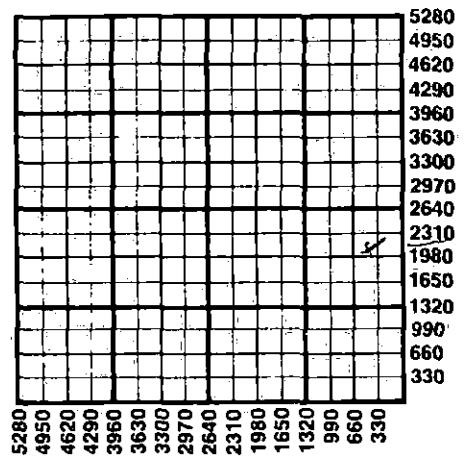

Important procedures to follow :

1. Notify District office before setting surface casing.
2. Set surface casing by circulating cement to the top.
3. File completion forms ACO-1 with K.C.C. within 90 days of well completion, following instructions on ACO-1, side 1, and including copies of wireline logs.
4. Notify District office 48 hours prior to old well workover or re-entry.
5. Prior to plugging, prepare a plugging plan, then obtain agreement from the appropriate district office for an approved plugging plan.
6. Submit plugging report (CP-4) to K.C.C. after plugging is completed.
7. Obtain an approved injection docket number before disposing of salt water.
8. Notify K.C.C. within 10 days when injection commences or terminates.
9. If an alternate 2 completion, cement in the production pipe from below any usable water to surface within 120 days of spud date.

State Corporation Commission of Kansas
Conservation Division
200 Colorado Derby Building
Wichita, Kansas 67202
(316) 263-3238