

CARD MUST BE TYPED

State of Kansas

CARD MUST BE SIGNED

NOTICE OF INTENTION TO DRILL

(see rules on reverse side)

Starting Date March 27 1986 month day year

API Number 15-151-21,780-00-40

OPERATOR: License # 8709
Name White Oilfield Supply Inc.
Address 914 West Third
City/State/Zip Pratt, KS 67124
Contact Person Russell White
Phone 316 672 7130

SE NE NE Sec. 20 Twp. 28 S, Rg. 15 East
4290 Ft. from South Line of Section
330 Ft. from East Line of Section

(Note: Locate well on Section Plat on reverse side)

CONTRACTOR: License # 9421
Name Boger Brothers Drilling Inc.
City/State Box 723, Great Bend, KS 67530

Nearest lease or unit boundary line 330 feet
County Pratt
Lease Name Chubb Well # 1

Well Drilled For: Well Class: Type Equipment:
Oil SWD Infield Mud Rotary
Gas Inj Pool Ext Air Rotary
OWWO Expl Wildcat Cable

Ground surface elevation ? feet MSL
Domestic well within 330 feet: yes X no
Municipal well within one mile: yes X no
Depth to bottom of fresh water 150
Depth to bottom of usable water 300
Surface pipe by Alternate: 1 X 2
Surface pipe planned to be set 400
Conductor pipe required
Projected Total Depth 4500 feet
Formation Arbuckle

If OWWO: old well info as follows:

Operator
Well Name
Comp Date Old Total Depth

I certify that well will comply with K.S.A. 55-101, et seq., plus eventually plugging hole to KCC specifications.

Date 3/24/86 Signature of Operator or Agent [Signature] Title as agent

For KCC Use:


Conductor Pipe Required 320 feet; Minimum Surface Pipe Required 320 feet per Alt. 1
This Authorization Expires 3-24-86 Approved By [Signature]

Must be filed with the K.C.C. five (5) days prior to commencing well  
This card void if drilling not started within six (6) months of date received by K.C.C.

**Important procedures to follow:**

1. Notify District office before setting surface casing.
2. Set surface casing by circulating cement to the top.
3. File completion forms ACO-1 with K.C.C. within 90 days of well completion, following instructions on ACO-1, side 1, and including copies of wireline logs.
4. Notify District office 48 hours prior to old well workover or re-entry.
5. Prior to filing Intent, prepare a proposed plugging plan in case well is D & A, then obtain approval of plan when calling district office prior to setting surface pipe.
6. Submit plugging report (CP-4) to K.C.C. after plugging is completed.
7. Obtain an approved injection docket number before disposing of salt water.
8. Notify K.C.C. within 10 days when injection commences or terminates.

**A Regular Section of Land  
1 Mile = 5,280 Ft.**

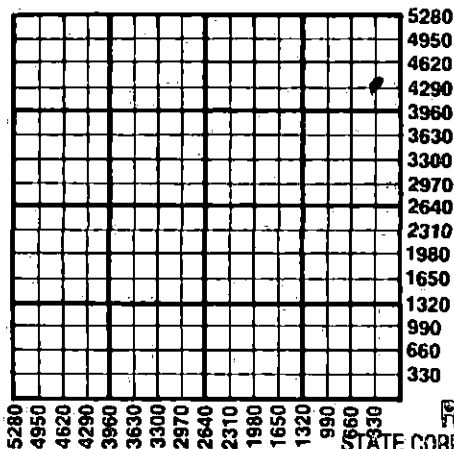

RECEIVED

STATE CORPORATION COMMISSION

MAR 24 1986  
03-24-86  
CONSERVATION DIVISION  
Wichita, Kansas

If an alternate 2 completion, cement in the production pipe from below any usable water to surface within 120 days of spud date.

State Corporation Commission of Kansas  
Conservation Division  
200 Colorado Derby Building  
Wichita, Kansas 67202  
(316) 263-3238