


STATE OF KANSAS
STATE CORPORATION COMMISSION

WELL PLUGGING RECORD

Give All Information Completely
Make Required Affidavit
Mail or Deliver Report to:
Conservation Division
State Corporation Commission
211 No. Broadway
Wichita, Kansas

Kiowa County. Sec. 27 Twp. 27S Rge. 16 (E) 16 (W)
Location as "NE/CNW/SW" or footage from lines C NE/4 NW/4
Lease Owner Walters Drilling Co., Honaker-Davis Drlg., et al
Lease Name Roethemeyer Well No. 1
Office Address 510 Orpheum Building, Wichita 2, Kansas
Character of Well (completed as Oil, Gas or Dry Hole) Dry Hole
Date well completed August 26, 19 58
Application for plugging filed (verbal) September 11, 19 58
Application for plugging approved (verbal) September 11, 19 58
Plugging commenced September 11, 19 58
Plugging completed September 11, 19 58
Reason for abandonment of well or producing formation Dry Hole

16W

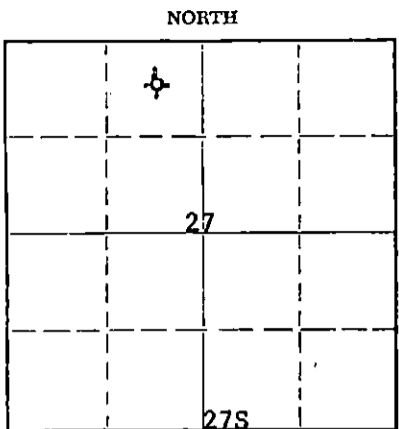

Locate well correctly on above Section Plat

If a producing well is abandoned, date of last production 19
Was permission obtained from the Conservation Division or its agents before plugging was commenced? Yes

Name of Conservation Agent who supervised plugging of this well W. L. Lackamp, Jr.
Producing formation None Depth to top Bottom Total Depth of Well 4732 Feet
Show depth and thickness of all water, oil and gas formations.

OIL, GAS OR WATER RECORDS

CASING RECORD

FORMATION	CONTENT	FROM	TO	SIZE	PUT IN	PULLED OUT
None	None	0	315'	8 5/8"	315'	None
Mississippian	None	0	4731.25	4 1/2"	3396.10 4731.25	3396.10

Describe in detail the manner in which the well was plugged, indicating where the mud fluid was placed and the method or methods used in introducing it into the hole. If cement or other plugs were used, state the character of same and depth placed, from feet to feet for each plug set.

Bailed fluid and mudded back to 315'. Set 10' rock bridge.
Mixed and run 20 sacks cement. Filled hole with mud to 40'.
Set 10' rock bridge. Mixed and dumped 10 sacks cement to base of cellar.

(If additional description is necessary, use BACK of this sheet)

Name of Plugging Contractor Southwest Casing Pulling Co., Inc.
Address P. O. Box 364, Great Bend, Kansas

STATE OF KANSAS, COUNTY OF SEDGWICK, ss.

Robert F. Walters (employee of owner) or (owner or operator) of the above-described well, being first duly sworn on oath, says: That I have knowledge of the facts, statements, and matters herein contained and the log of the above-described well as filed and that the same are true and correct. So help me God.

(Signature) Robert F. Walters
510 Orpheum Building, Wichita 2, Kansas
(Address)

SUBSCRIBED AND SWORN to before me this 22nd day of September, 19 58

My commission expires March 10, 1960

Pauline Anderson (Notary Public)

RECEIVED
PLUGGING SEP 24 1958
FILE SEC 27 T 27 R 16W
BOOK PAGE 127 LINE 35
CONSERVATION DIVISION
Kansas
9-24-1958

DRILLERS' LOG

Roethemeyer No. 1
Loc C NE NW
Sec: 27-27S-16W
Kiowa County, Kansas
Company: Walters Drilling Co., et al
Contractor: Honaker-Davis Drlg. Co.

Comm: 7-15-58
Comp: 7-29-58
Rotary Total Depth: 4732'
Casing: 8 5/8" at 315'
4 1/2" at 4731'

0	100	Top Soil & Sand	
100	220	Sand & Shale	8 5/8" casing cemented at
220	450	Shale	315' with 225 sacks cement
450	495	Sand	and 4 sacks calcium chloride.
495	1010	Red Bed & Shale	
1010	1035	Anhydrite	
1035	2120	Shale & Shells	
2120	2225	Shale & Lime	
2225	4097	Lime & Shale	
4097	4158	Lime	
4158	4230	Lime & Shale	
4230	4470	Lime	
4470	4525	Lime & Shale	
4525	4575	Lime	4 1/2" casing cemented at
4575	4732	Lime & Chert	4731' with 200 sacks cement.
4732		Total Rotary Depth	

I certify that this is the true and correct copy of the above log to the best of my knowledge.


H. S. Forbes

Subscribed and sworn to before me this 5th day of August, 1958.


Kenneth G. Fischer, Notary Public

My commission expires: 6-25-59

RECEIVED
NOTARY COMMISSION
PLUGGING 4 1958
FILE SEC. 27 T. 27 R. 16W. DIVISION
BOOK PAGE 127 LINE 35