


STATE OF KANSAS  
STATE CORPORATION COMMISSION

WELL PLUGGING RECORD

Give All Information Completely  
Make Required Affidavit  
Mail or Deliver Report to:  
Conservation Division  
State Corporation Commission  
211 No. Broadway  
Wichita, Kansas

Kiowa County, Sec. 28 Twp. 27S Rge. (E) 16 (W)  
Location as "NE/CNWxSWx" or footage from lines SW SW SW  
Lease Owner Jones, Shelburne & Farmer, Inc.  
Lease Name FRUIT Well No. 1  
Office Address Russell, Kansas  
Character of Well (completed as Oil, Gas or Dry Hole) Dry  
Date well completed 8-2 19 56  
Application for plugging filed 8-2 19 56  
Application for plugging approved 8-2 19 56  
Plugging commenced 8-2 19 56  
Plugging completed 8-2 19 56  
Reason for abandonment of well or producing formation Dry

NORTH

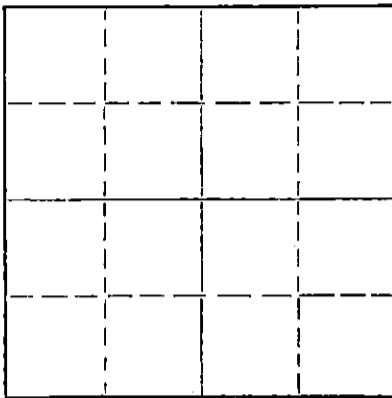

Locate well correctly on above  
Section Plat

If a producing well is abandoned, date of last production 19  
Was permission obtained from the Conservation Division or its agents before plugging was commenced? Yes

Name of Conservation Agent who supervised plugging of this well M. A. Rives  
Producing formation \_\_\_\_\_ Depth to top \_\_\_\_\_ Bottom \_\_\_\_\_ Total Depth of Well 5005 Feet  
Show depth and thickness of all water, oil and gas formations.

OIL, GAS OR WATER RECORDS

CASING RECORD

FORMATION	CONTENT	FROM	TO	SIZE	PUT IN	PULLED OUT
				8-5/8"	265	None

Describe in detail the manner in which the well was plugged, indicating where the mud fluid was placed and the method or methods used in introducing it into the hole. If cement or other plugs were used, state the character of same and depth placed, from \_\_\_\_\_ feet to \_\_\_\_\_ feet for each plug set.

1. Filled hole with heavy mud to bottom surface pipe
2. Pushed plug to within 5 feet of bottom of surface pipe
3. Pulled drill pipe
4. Dumped in 1/2 sack hulls
5. Ran drill pipe back in and cemented through drill pipe
6. Cemented with 20 sacks on bottom-10 sacks on top
7. Filled hole with mud and then pushed plug to 35 feet
8. Dumped in 1/2 sack hulls
9. Dumped in 10 sacks through drill pipe to fill hole to top.

(If additional description is necessary, use BACK of this sheet)

Name of Plugging Contractor Jones, Shelburne & Farmer, Inc.  
Address Russell, Kansas

STATE OF Kansas, COUNTY OF Russell, ss.  
JOHN O. FARMER (employee of owner) or (owner or operator) of the above-described well, being first duly sworn on oath, says: That I have knowledge of the facts, statements, and matters herein contained and the log of the above-described well as filed and that the same are true and correct. So help me God.

(Signature) John O. Farmer  
Russell, Kansas  
(Address)

SUBSCRIBED AND SWORN TO before me this 3rd day of August, 1956

My commission expires 10-11-58

Lucius E. [Signature]  
CORPORATION COMMISSION Notary Public.

AUG 13 1956

CONSERVATION DIVISION  
Wichita, Kansas

8-13-1956

PLUGGING  
FILE SEC 28 T 27 R 16w  
BOOK PAGE 87 LINE 14