


STATE OF KANSAS
STATE CORPORATION COMMISSION

Form CP-4

Give All Information Completely
Make Required Affidavit
Mail or Deliver Report to:
Conservation Division
State Corporation Commission
P. O. BOX 17027
Wichita, Kansas 67217
NORTH

WELL PLUGGING RECORD

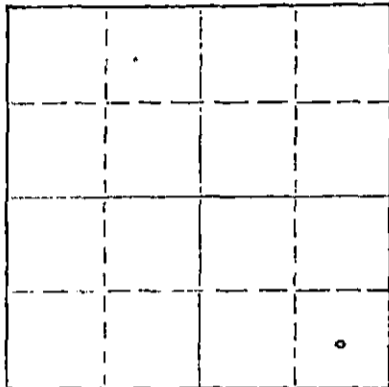

Locate well correctly on above
Section Plat

Kiowa County. Sec. 29 Twp. 27 Rge. (E) 16(W)
Location as "NE/CNW/SW" or footage from lines C SE SE
Lease Owner TGT Petroleum Corporation
Lease Name Boles Well No. 1
Office Address Suite 350, Sutton Place, Wichita, Kansas 67202
Character of Well (completed as Oil, Gas or Dry Hole) oil
Date well completed 19
Application for plugging filed 19
Application for plugging approved 19
Plugging commenced April 15 19 74
Plugging completed June 3 19 74
Reason for abandonment of well or producing formation depleted
If a producing well is abandoned, date of last production 19
Was permission obtained from the Conservation Division or its agents before plugging was commenced? yes

Name of Conservation Agent who supervised plugging of this well G. R. Biberstein
Producing formation Depth to top Bottom Total Depth of Well 4710 Feet
Show depth and thickness of all water, oil and gas formations.

OIL, GAS OR WATER RECORDS

CASING RECORD

| FORMATION | CONTENT | FROM | TO | SIZE | PUT IN | PULLED OUT |
|-----------|---------|------|-------|--------|--------|------------|
| | | 0 | 287' | 8 5/8" | 287' | none |
| | | | 4707' | 4 1/2" | 4707' | 2782.67 |
| | | | | | | |
| | | | | | | |
| | | | | | | |
| | | | | | | |
| | | | | | | |
| | | | | | | |

Describe in detail the manner in which the well was plugged, indicating where the mud fluid was placed and the method or methods used in introducing it into the hole. If cement or other plugs were used, state the character of same and depth placed, from feet to feet for each plug set.

Pumped bottom hole with 10 sacks of cement. Spotted plug at 4600'.
Halliburton plugged well pumping in 2 sacks of hulls, 10 sacks of gel and 100 sacks of cement.

RECEIVED
STATE CORPORATION COMMISSION
JUN 6 1974
CONSERVATION DIVISION
Wichita, Kansas

(If additional description is necessary, use BACK of this sheet)
Name of Plugging Contractor PIPE PULLERS, INC.
Address Box 486, Ellinwood, Kansas 67526

STATE OF KANSAS COUNTY OF BARTON ss.
Evelyn Roth (employee of owner) or (owner or operator) of the above-described

well, being first duly sworn on oath, says: That I have knowledge of the facts, statements, and matters herein contained and the log of the above-described well as filed and that the same are true and correct. So help me God.

(Signature) Evelyn Roth
Ellinwood, Kansas (Address)

SUBSCRIBED AND SWORN TO before me this 4th day of June, 19 74

George A. Meyer
Notary Public

My commission expires Feb. 10, 1975

GABBERT-JONES, INC.
WICHITA, KANSAS
DRILLERS' WELL LOG

RECEIVED
 STATE CORPORATION COMMISSION
 FEB 20 1974
 CONSERVATION DIVISION
 Wichita, Kansas

BOLES #1
 C SE SE SECTION 29-275-16W
 KIOWA COUNTY, KANSAS

COMMENCED: SEPTEMBER 6, 1966
 COMPLETED: SEPTEMBER 18, 1966

OPERATOR - J. MARK RICHARDSON

| DEPTH | | FORMATION | REMARKS |
|-------|------|----------------------|---|
| FROM | TO | | |
| 0 | 65 | SAND AND GRAVEL | |
| 65 | 155 | SAND AND SHALE | |
| 155 | 287 | SHALE | RAN 12 JOINTS OF 8-5/8" CASING, SET @ 287' w/240 BAGS CEMENT. |
| 287 | 1022 | RED BED AND SHALE | |
| 1022 | 1052 | ANHYDRITE | |
| 1052 | 1705 | SHALE AND SHELLS | |
| 1705 | 3937 | LIME AND SHALE | |
| 3937 | 4002 | SAND AND SHALE | |
| 4002 | 4140 | SAND, LIME AND SHALE | |
| 4140 | 4668 | LIME | |
| 4668 | 4690 | LIME AND SHALE | |
| 4690 | 4708 | LIME AND CHERT | |
| 4708 | 4710 | LIME | |
| 4710 | TD | | RAN 146 JOINTS OF 4 1/2" CASING, SET @ 4707' w/200 BAGS CEMENT. |

I, E. E. HALL, CERTIFY THIS IS A CORRECT COPY OF THE DRILLERS' LOG FOR THE WELL DRILLED IN THE C SE SE SECTION 29-275-16W, KIOWA COUNTY, KANSAS, TO THE BEST OF MY KNOWLEDGE AND BELIEF.




 E. E. HALL

STATE OF KANSAS)
) SE
 COUNTY OF SEDGWICK)

BEFORE ME, THE UNDERSIGNED, A NOTARY PUBLIC WITHIN AND FOR SAID COUNTY AND STATE, ON THIS 21ST DAY OF SEPTEMBER, 1966, PERSONALLY APPEARED E. E. HALL, TO ME PERSONALLY KNOWN TO BE THE IDENTICAL PERSON WHO EXECUTED THE WITHIN AND FOREGOING INSTRUMENT AND ACKNOWLEDGED TO ME THAT HE EXECUTED THE SAME AS HIS FREE AND VOLUNTARY ACT AND DEED FOR THE USES AND PURPOSES THEREIN SET FORTH.

IN WITNESS WHEREOF, I HAVE HEREUNTO SET MY HAND AND OFFICIAL SEAL THE DAY AND YEAR LAST ABOVE WRITTEN.

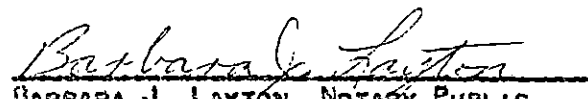

 BARBARA J. LAYTON, NOTARY PUBLIC

MY COMMISSION EXPIRES FEBRUARY 1, 1968.