


STATE OF KANSAS
STATE CORPORATION COMMISSION
200 Colorado Derby Bldg.
Wichita, Kansas 67202

RECEIVED Form CP-4
Rev. 12-15-80
STATE CORPORATION COMMISSION
JAN 25 1983
CONSERVATION DIVISION
Wichita, Kansas

WELL PLUGGING RECORD

Give All Information Completely
Make Required Affidavit

COUNTY Kiowa SEC. 32 TWP. 27S RGE. 16 E/W
Location as in quarters or footage from lines:
C N W S E

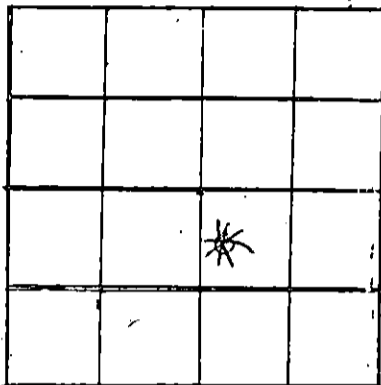

Locate Well
correctly on above
Section Platt.

Lease Owner Koch Oil Co.
Lease Name Woodward Well No. 1
Office Address Box 2256 Wichita, Kansas
Character of Well (Completed as Oil, Gas or Dry Hole): Oil
Date Well Completed 4-22-66
Application for plugging filed _____
Plugging commenced _____
Plugging completed 12-16-82
Reason for abandonment of well or producing formation
not economical to produce

Was permission obtained from the Conservation Division or it's
Agent's before plugging was commenced? yes

Name of Conservation Agent who supervised plugging of this well W. McArthur Litchi
Producing formation Kansas City Depth to top 4230 bottom 4663 T.D. 4900
Show depth and thickness of all water, oil and gas formations.

OIL, GAS OR WATER RECORDS

Casing Record

Formation	Content	From	To	Size	Put in	Pulled Out
Surface water		0	328	8 5/8		0
4 1/2 casing		0	4900	4 1/2		2394'

Describe in detail the manner in which the well was plugged, indicating where the mud
fluid was placed and the method or methods used in introducing it into the hold. If cement
or other plugs were used, state the character of same and depth placed, from _____ feet
to _____ feet for each plug set.

Sanded from CIBP to 4100' with 5 sacks of common cement on top dumped with
bailer. Shot off 4 1/2" casing at 2394' and laid down. Halliburton plugged surface
pipe 8 5/8" with 3 sacks hulls, 20 sacks gel, 70 sacks cement, 15 sacks gel, 1 sack
hulls, plug, 120 sacks cement (50/50 poz mix 2% gel, 3% CC). Plug down at 9:00AM,
pumping pressure:
ISIP:

(If additional description is necessary, use BACK of this sheet)

Name of Plugging Contractor Pratt Well Service, Inc. Box 847 Pratt, Kansas 67124

STATE OF Kansas COUNTY OF Pratt, ss.
Judy Baird (employee of owner) or (owner or operator) of the
above-described well, being first duly sworn on oath, says: That I have knowledge of the
facts, statements, and matters herein contained and the log of the above-described well as
filed and that the same are true and correct. So help me God.



(Signature) Judy Baird
Box 847 - Pratt, Mo. 67124
(Address)

SUBSCRIBED AND SWORN TO before me this 24th day of January, 19 83
Charlene M. Dudley
Notary Public.

My Commission expires: 9/10/83