


STATE OF KANSAS
 STATE CORPORATION COMMISSION

WELL PLUGGING RECORD

Give All Information Completely
 Make Required Affidavit
 Mail or Deliver Report to
 Conservation Division
 State Corporation Comm.
 245 North Water
 Wichita, KS 67202

Kiowa County, Sec. 11 Twp. 27S Rge. 16W E/W
 Location as "NE/CNW $\frac{1}{2}$ SW $\frac{1}{2}$ " or footage from lines
 E/2 NE NW
 Lease Owner Beren Corporation
 Lease Name DeHaven Well No. #2
 Office Address 970 4th Fin. Ctr., Wichita, Kansas 67202
 Character of Well (Completed as Oil, Gas or Dry Hole)
 Dry

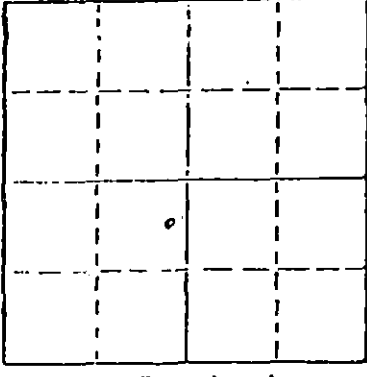

Locate well correctly on above
 Section Plot

Date Well completed August 17, 1982
 Application for plugging filed August 17, 1982
 Application for plugging approved August 17, 1982
 Plugging commenced August 17, 1982
 Plugging completed August 17, 1982
 Reason for abandonment of well or producing formation
 Dry Hole

If a producing well is abandoned, date of last production
 19

Was permission obtained from the Conservation Division or
 its agents before plugging was commenced? Yes

Name of Conservation Agent who supervised plugging of this well Steve Durrant
 Producing formation Depth to top Bottom Total Depth of Well

Show depth and thickness of all water, oil and gas formations.

OIL, GAS OR WATER RECORDS

CASING RECORD

FORMATION	CONTENT	FROM	TO	SIZE	PUT IN	PULLED OUT

Describe in detail the manner in which the well was plugged, indicating where the mud fluid
 was placed and the method or methods used in introducing it into the hold. If cement or other
 plugs were used, state the character of same and depth placed, from feet to
 feet for each plug set.

Plugged: 50 sks @ 780'
 60 sks @ 450'
 10 sks @ 40-0'
 Circ. 10 sks Rat Hole
 " 10 sks Mouse Hole

Cement:

(If additional description is necessary, use BACK of this sheet)

Name of Plugging Contractor Halliburton

STATE OF Kansas COUNTY OF Sedgwick, ss.
Jerome D. Marcus (employee of owner) or (owner or operator)
 of the above-described well, being first duly sworn on oath, says: That I have knowledge of
 the facts, statements, and matters herein contained and the log of the above-described well
 as filed and that the same are true and correct. So help me God.

(Signature) [Signature]
401 E. Douglas, Suite 402, Wichita, Kansas 67202
 (Address)

SUBSCRIBED AND SWORN TO before me this 25th day of August, 19 82

Cheryl L. Benoit
 Notary Public.

My commission expires June 8, 1985

