

STATE OF KANSAS  
STATE CORPORATION COMMISSION


15-185-21123-00-00

WELL PLUGGING RECORD

Give All Information Completely  
Make Required Affidavit  
Mail or Deliver Report to  
Conservation Division  
State Corporation Comm.  
245 North Water  
Wichita, KS 67202

Stafford County. Sec. 19 Twp. 24S Rge. 12W-E/W-  
Location as "NE/CNW $\frac{1}{4}$ SW $\frac{1}{4}$ " or footage from lines  
SW SW NW

Lease Owner Ram Petroleum Company  
Lease Name Galloway Well No. 1  
Office Address 800 Vickers KSB&T Bldg., Wichita, KS  
Character of Well (Completed as Oil, Gas or Dry Hole) 67202  
Dry Hole

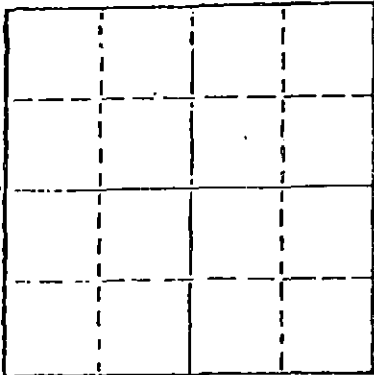

Locate well correctly on above  
Section Plot

Date Well completed September 13, 19 80  
Application for plugging filed Verbal Application 19  
Application for plugging approved Verbal Application 19  
Plugging commenced September 13, 19 80  
Plugging completed September 13, 19 80  
Reason for abandonment of well or producing formation

If a producing well is abandoned, date of last production 19

Was permission obtained from the Conservation Division or  
its agents before plugging was commenced? Yes

Name of Conservation Agent who supervised plugging of this well Duane L. Rankin  
Producing formation Depth to top Bottom Total Depth of Well 4,002'  
Show depth and thickness of all water, oil and gas formations.

OIL, GAS OR WATER RECORDS

CASING RECORD

FORMATION	CONTENT	FROM	TO	SIZE	PUT IN	PULLED OUT
				8-5/8"	327'	None

Describe in detail the manner in which the well was plugged, indicating where the mud fluid was placed and the method or methods used in introducing it into the hold. If cement or other plugs were used, state the character of same and depth placed, from feet to feet for each plug set.

Filled hole with heavy rotary mud from 4,200 ft. (rotary total depth) to 480 ft. Set plug at 480 ft. and cemented with 30 sacks cement. Filled hole with heavy rotary mud from 480 ft. to 300 ft. Set plug at 300 ft. and cemented with 30 sacks cement. Filled hole with heavy rotary mud from 300 ft. to 40 ft. Set solid plug at 40 ft. and cemented to cellar with 10 sacks cement, 5 sacks cement in rat hole, 5 sacks cement in mouse hole and gell and hulls in water well.

Plugging operations accomplished utilizing Sun Oil well cementing pump truck through 4 1/2 inch drill pipe.

(If additional description is necessary, use BACK of this sheet)


Name of Plugging Contractor Sun Oil Well Cementing, Inc.  
Box 169, Great Bend, Kansas 67530

STATE OF Kansas COUNTY OF Sedgwick  
Dean Britting, Agent

of the above-described well, being first duly sworn on oath, says: That I have knowledge of the facts, statements, and matters herein contained and the log of the above-described well as filed and that the same are true and correct. So help me God.


(Signature) Dean Britting  
251 N. Water #10, Wichita, Kansas 67202  
(Address)

SUBSCRIBED AND SWORN TO before me this 23rd day of September, 1980

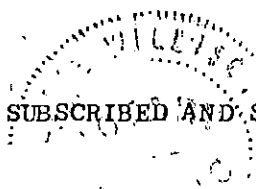

Elsie Willison  
Elsie Willison - Notary Public.

My commission expires July 25, 1982

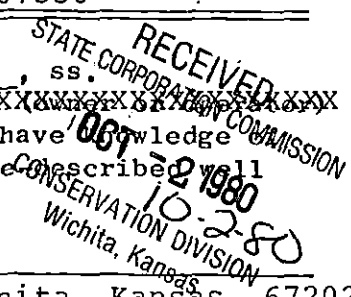

KANSAS DRILLERS LOG

COMPANY Ram Petroleum Company  
 FARM Galloway NO. 1

SEC. 19 T. 24S R. 12W  
 LOC. SW SW SW

COUNTY Stafford

ROTARY TOTAL DEPTH 4,200'  
 COMM. September 3, 1980 COMP. September 13, 1980  
 CONTRACTOR Freeman Drilling Company (Rig #1)  
 ISSUED September 23, 1980

CASING

10 3/4"  
 8 5/8" Set at 327' cemented w/250 sxs cement  
 5 1/2"  
 4 1/2"

ELEVATION 1,910' K.B.

FIGURES INDICATE BOTTOM OF FORMATIONS

Sand and Shale	327'
Red Bed and Shale	412'
Shale	2,989'
Shale and Lime	3,259'
Lime and Shale	3,416'
Shale	3,519'
Shale and Lime	3,623'
Lime and Shale	3,754'
Lime	3,993'
Lime and Shale	4,042'
Lime	4,147'
Lime and Shale	4,200'
Rotary Total Depth	4,200'

"I hereby certify the above and foregoing to be  
 a true and correct log of the above described  
 well as shown by the drilling reports.

FREEMAN DRILLING COMPANY

*Dean Britting*  
 Dean Britting

State of Kansas )  
 ) ss:  
 County of Sedgwick )

Subscribed and Sworn to before me a Notary Public  
 in and for said county and state this 23rd day of  
 September, 1980.

RECEIVED  
 STATE CORPORATION COMMISSION  
 OCT - 2 1980  
 CONSERVATION DIVISION  
 Wichita, Kansas

WILLISON  
 NOTARY PUBLIC

*Elsie Willison*  
 Elsie Willison - Notary Public

My Commission Expires:  
 July 25, 1982