

STATE OF KANSAS
STATE CORPORATION COMMISSION

WELL PLUGGING RECORD

Give All Information Completely
Make Required Affidavit
Mail or Deliver Report to
Conservation Division
State Corporation Comm.
245 North Water
Wichita, KS 67202

FORD County. Sec. 35 Twp. 29S Rge. 22W E/W
Location as "NE/CNW $\frac{1}{4}$ SW $\frac{1}{4}$ " or footage from lines
150' NE of NE SE


Lease Owner PICKRELL DRILLING COMPANY
Lease Name SEIBEL Well No. 1
Office Address 205 LITWIN BLDG. WICHITA, KANSAS 67202
Character of Well (Completed as Oil, Gas or Dry Hole)
DRY HOLE

Date Well completed 2-4-80 19
Application for plugging filed 2-4-80 19
Application for plugging approved 2-4-80 19
Plugging commenced 2-4-80 19
Plugging completed 2-4-80 19
Reason for abandonment of well or producing formation
DRY HOLE

If a producing well is abandoned, date of last production 19

Was permission obtained from the Conservation Division or its agents before plugging was commenced? YES

Name of Conservation Agent who supervised plugging of this well Clarence Thomas, Jr.
Producing formation _____ Depth to top _____ Bottom _____ Total Depth of Well 5405'
Show depth and thickness of all water, oil and gas formations.

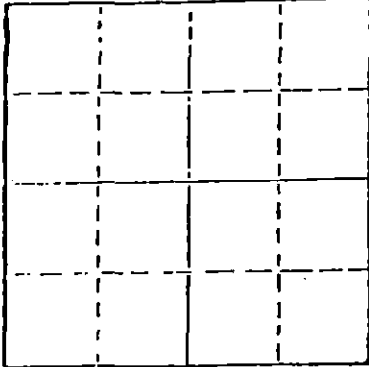

Locate well correctly on above Section Plat

OIL, GAS OR WATER RECORDS

CASING RECORD

FORMATION	CONTENT	FROM	TO	SIZE	PUT IN	PULLED OUT
				8 5/8	324'	NONE

Describe in detail the manner in which the well was plugged, indicating where the mud fluid was placed and the method or methods used in introducing it into the hold. If cement or other plugs were used, state the character of same and depth placed, from _____ feet to _____ feet for each plug set.

50 sx @ 300'
10 sx @ 40' w/solid bridge plug
5 sx in rathole COMP. 12:30 PM 2-4-80

2-13-80

(If additional description is necessary, use BACK of this sheet)

Name of Plugging Contractor PICKRELL DRILLING COMPANY

RECEIVED
STATE CORPORATION COMMISSION

STATE OF KANSAS COUNTY OF SEDGWICK
C.W. SEBITS (employee of owner) or (owner, or operator)
of the above-described well, being first duly sworn on oath, says: That I have knowledge of the facts, statements, and matters herein contained and the log of the above-described well as filed and that the same are true and correct. So help me God. BY: C.W. SEBITS

(Signature) *C.W. Sebits*
205 LITWIN BLDG., WICHITA, KANSAS 67202
(Address)

FEB 13 1980

SUBSCRIBED AND SWORN TO before me this 11th day of February, 19 80.

My commission expires 2-18-84

Jo Ann Sarver
Jo Ann Sarver Notary Public.



ROTARY DRILLING LOG

COMPANY: PICKRELL DRILLING COMPANY
225 LITWIN BLDG.
WICHITA, KANSAS 67202
LOCATION: 1-ASSEIBEL
150' NE of NE SE Sec. 35-29S-22W
FORD COUNTY, KANSAS
CONTRACTOR: **PICKRELL DRILLING COMPANY**
Wichita, Kansas

Rotary Drilling Commenced 1-22-80
Rotary Drilling Completed 2-4-80

CASING RECORD: Spud date 1-22-80 Surf. pipe 8 5/8 set at 324' w/210 sacks

LOG

(Figures indicate bottom of formation — measurements from top of rotary bushing.)

Top soil	40
Clay & native	90
Sand	185
Blue shale	517
Shale	990
Shale & lime	1700
Shale Anhy	2210
Shale	2315
Shale	2370
Lime & shale	2590
Shale	2895
Lime & shale	3030
Lime & shale	3172
Lime & shale	3315
Lime & shale	3450
Lime	3575
Lime & shale	3725
Lime & shale	3850
Lime & shale	3987
Lime & shale	4200
Lime & shale	4345
Lime	4477
Lime	4630
Lime & shale	4755
Lime & shale	4860
Lime & shale	4945
Lime & shale	5025
Lime	5092
Lime	5175
Lime	5240
Lime	5285

RECEIVED
STATE CORPORATION COMMISSION

FEB 13 1980

The undersigned, C.W. Sebitts, Attorney-in-Fact for PICKRELL DRILLING COMPANY, hereby certifies in behalf of said Company, that the above is a true and correct log of the formation encountered in drilling the above well as reflected by the Daily Drilling Reports.

PICKRELL DRILLING COMPANY
By [Signature]
Attorney-in-Fact
C.W. Sebitts

STATE OF KANSAS }
COUNTY OF SEDGWICK } ss.:

On this 11th day of February, 1980, before me the undersigned, a Notary Public, in and for the County and State aforesaid, personally appeared C. W. Sebitts, Partner and Attorney-in-Fact, to me known to be the identical person who subscribed the name of PICKRELL DRILLING COMPANY to the foregoing instrument as its Attorney-in-Fact and acknowledged to me that he executed the same as his free and voluntary act and deed, and as the free and voluntary act and deed of such company, for the uses and purposes therein set forth.

Given under my hand and seal of office the day and year last above written.

My commission expires: 2-18-84

[Signature]
Notary Public
Jo Ann Sarver

