

STATE OF KANSAS
STATE CORPORATION COMMISSION
200 Colorado Derby Building
Wichita, Kansas 67202

WELL PLUGGING RECORD
K.A.R.-82-3-117

API NUMBER 15-057-20490 - 0000

LEASE NAME Scheufler

TYPE OR PRINT
NOTICE: Fill out completely
and return to Cons. Div.
office within 30 days.

WELL NUMBER D-1

 Ft. from S Section Line

 Ft. from E Section Line

SEC. 29 TWP. 29 RGE. 22 (E) or (W)

COUNTY Ford

LEASE OPERATOR Pickrell Drilling Co Inc.

ADDRESS 110 N Main, St 205, Wichita, Kansas 67202

PHONE# B16 262-8427 OPERATORS LICENSE NO. 5123

Date Well Completed 11-90

Character of Well Oil

Plugging Commenced 3-9-92

(Oil, Gas, D&A, SWD, Input, Water Supply Well)

Plugging Completed 12:15 PM

The plugging proposal was approved on 3-9-92 (date)

by Steve Middleton (KCC District Agent's Name).

Is ACO-1 filed? Yes If not, Is well log attached? Yes

Producing Formation Morrow Depth to Top 5276 Bottom 5288 T.D. 5450

Show depth and thickness of all water, oil and gas formations.

OIL, GAS OR WATER RECORDS

CASING RECORD

Formation	Content	From	To	Size	Put In	Pulled out
				8 5/8	497	0
				4 1/2	5420	3032

Describe in detail the manner in which the well was plugged, indicating where the mud fluid was placed and the method or methods used in introducing it into the hole. If cement or other plugs were used, state the character of same and depth placed, from feet to feet each set.
Bottom plug: sanded to 5200 ft & bailed 4 sx cement.

Top plug: pumped 300 lbs Hulls, 10 sx gel, 50 sx cement, 10 sx gel, 100 lbs Hulls, 8 5/8 wiper plug, 150 sx 60/40% gel. Had 300 lbs max pressure & 100 lbs shut in.

(If additional description is necessary, use BACK of this form.)

Name of Plugging Contractor Great Bend Casing Pullers, Inc. License No. 4635 CP

Address Box 251, Great Bend, Kansas 67530

RECEIVED
STATE CORPORATION COMMISSION

NAME OF PARTY RESPONSIBLE FOR PLUGGING FEES: Danny Biggs

MAR 12 1992

STATE OF Kansas COUNTY OF Barton, ss.

Anna K. Burke

CONSERVATION DIVISION


(Employee of Operation), (Operator)

above-described well, being first duly sworn on oath, says: That I have knowledge of the facts stated, and matters herein contained and the log of the above-described well as filed therewith, and the same are true and correct, so help me God.

(Signature) Anna K. Burke

(Address) Box 251, Great Bend, Kansas 67530

SUBSCRIBED AND SWORN TO before me this 10 day of March, 19 92

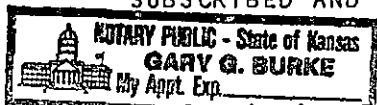

My Commission Expires: 4-30-93

Gary G. Burke
Notary Public

WELL FILE ~~LOG FILE~~
PICKRELL DRLG. CO.
GEOLOGICAL REPORT

DRILLING TIME
AND
SAMPLE LOG

COMPANY Pickrell Drilling Co., Inc.
LEASE Scheufler 50" WELL NO 1
FIELD Wildcat
LOCATION S1 NE1 SW1
SECTION 29 TOWNSHIP 29S RANGE 22W
COUNTY Ford STATE Kansas

ELEVATIONS -
KB. 2468 FEET
DF 2465 FEET
G.L. 2463 FEET
MEASUREMENTS ARE ALL
FROM KB 2468

CONTRACTOR Company Tools RIG NO. _____
COMMENCED DRILLING Spud October 29, 1990
COMPLETED DRILLING November 8, 1990
RTD 5450 FEET LTD 5448 FEET.
MUD UP AT 4975 FEET MUD TYPE chemical
Dombar

CASING
8 5/8" @ 497' w/200sx
4 1/2" @ 5420' w/150sx

ELECTRICAL SURVEYS
Schlumberger
Comp. Neutron Litho-
Density
Dual Induction-SFL


SAMPLES SAVED FROM 4200 FEET TO 5450 FEET
DRILLING TIME KEPT FROM 4200 FEET TO 5450 FEET
SAMPLES EXAMINED FROM 4200 FEET TO 5450 FEET
GEOLOGICAL SUPERVISION FROM 4585 FEET TO 5450 FEET
GEOLOGIST Billy G. Klaver

NOTES E-log Tops: Heebner 4382(-1914), Brown Lime 4548(-2080),
Lansing 4562(-2094), Stark 4910(-2442), Base Kansas City 5017(-2549
Base Pawnee 5165(-2697), Cherokee 5192(-2724), Base Inola 5260
(-2892), Mississippi 5303(-2835).

RECEIVED
STATE CORPORATION COMMISSION
JAN 23 1992
CONSERVATION DIVISION
Wichita, Kansas

New Completion Workover

Oil Company _____ Well No. D-1 Field _____ Lease Scheufler
Company Man _____ Date Drilled 11/90 County Ford State KS

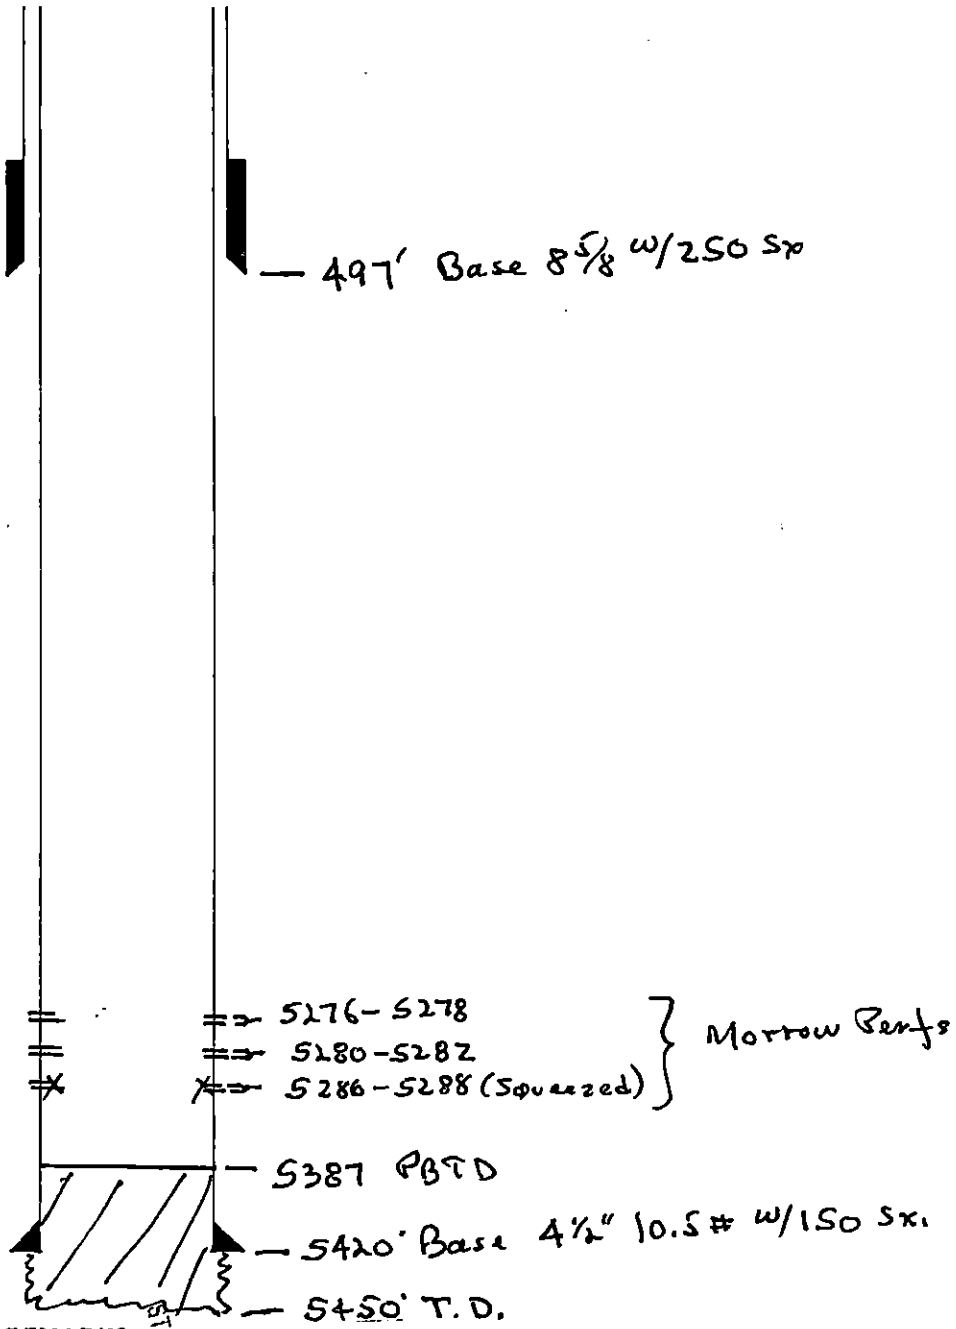

REMARKS: _____

RECEIVED
 OPERATIONAL DIVISION
 NOV 6 3 1992
 STATE OF KANSAS
 DEPARTMENT OF REVENUE