


STATE OF KANSAS
STATE CORPORATION COMMISSION

WELL PLUGGING RECORD

Give All Information Completely
Make Required Affidavit
Mail or Deliver Report to:
Conservation Division
State Corporation Commission
211 No. Broadway
Wichita, Kansas

FORD County. Sec. 8 Twp. 29 Rge. 22 (E) (NW)
Location as "NE/CNW/SW" or footage from lines C-NW-NW-SE
Lease Owner Russell Cobb, Jr., Inc.
Lease Name Stempert Well No. 1
Office Address 811 Thompson Building, Tulsa, Oklahoma
Character of Well (completed as Oil, Gas or Dry Hole) Dry
Date well completed January 10, 1961 19 61
Application for plugging filed January 6, 1961 19 61
Application for plugging approved January 17, 1961 19 61
Plugging commenced March 8, 1961 19 61
Plugging completed March 11, 1961 19 61
Reason for abandonment of well or producing formation Dry

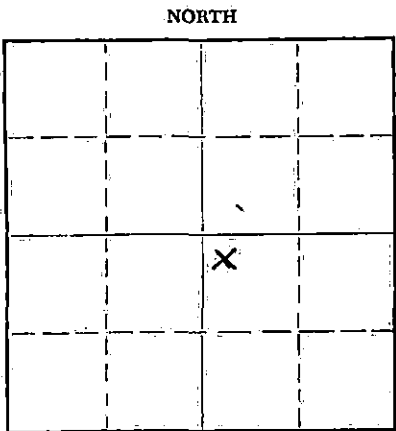

Locate well correctly on above
Section Plat

If a producing well is abandoned, date of last production - - - 19
Was permission obtained from the Conservation Division or its agents before plugging was commenced? Yes

Name of Conservation Agent who supervised plugging of this well Frank Broadfoot
Producing formation _____ Depth to top _____ Bottom _____ Total Depth of Well 3120 Feet
Show depth and thickness of all water, oil and gas formations.

OIL, GAS OR WATER RECORDS

CASING RECORD

FORMATION	CONTENT	FROM	TO	SIZE	PUT IN	PULLED OUT
Herrington	Lime & Shale	2780	2792	8-5/8	348	None
Krider	Lime & Shale	2792	2820	4-1/2	3117	2507
Winfield	Dolomite	2820	2881			
Towanda	" & Shale	2881	2918			
Fort Riley	" "	2918	2971			
Florence	Dol, Sha & Lime	3971	3120			
Total Depth	" " "	3120				

Describe in detail the manner in which the well was plugged, indicating where the mud fluid was placed and the method or methods used in introducing it into the hole. If cement or other plugs were used, state the character of same and depth placed, from _____ feet to _____ feet for each plug set.

Plugged back with sand to 2740' mixed and run 5 sacks cement. Cleaned out cellar. Mudded hole to 300' set 10' rock bridge mixed and run 20 sacks cement, with dump bailor. Mud to 40' set 10' rock bridge with 10 sacks cement to base of cellar. Cleaned up location. Well Complete.

RECEIVED
STATE CORPORATION COMMISSION

JUL 13 1961

CONSERVATION DIVISION
Wichita, Kansas

(If additional description is necessary, use BACK of this sheet)
Name of Plugging Contractor Southwest Casing Pulling Company, Inc.
Address Box 364 Great Bend, Kansas

STATE OF OKLAHOMA, COUNTY OF TULSA, ss.

I, Martin L. Straub (employee of owner) or (owner or operator) of the above-described well, being first duly sworn on oath, says: That I have knowledge of the facts, statements, and matters herein contained and the log of the above-described well as filed and that the same are true and correct. So help me God.

(Signature) Martin L. Straub
Tulsa, Oklahoma (Address)

SUBSCRIBED AND SWORN TO before me this 11th day of July, 1961

My commission expires 9-19-61

