

RECEIVED
STATE CORPORATION COMMISSION


NOV 20 1975

CONSERVATION DIVISION
Wichita, Kansas

FORM CP-4

STATE OF KANSAS
STATE CORPORATION COMMISSION
CONSERVATION DIVISION
P. O. BOX 17027
WICHITA, KANSAS 67217

WELL PLUGGING RECORD

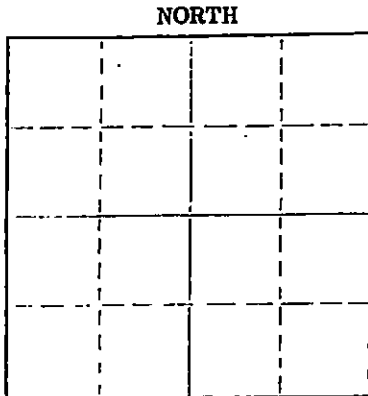

Locate well correctly on above
Section Plat

Ford County. Sec. 28 Twp. 29 Rge. 21 (E) (W)
Location as "NE/CNW4SW4" or footage from lines. NE NE NW
Lease Owner Maurice L. Brown
Lease Name Lane Estate #1 Well No.
Office Address Wichita, Kansas 67202
Character of Well (completed as Oil, Gas or Dry Hole)
Date well completed 19
Application for plugging filed 19
Application for plugging approved 19
Plugging commenced 11/5/75 19
Plugging completed 11/15/75 19
Reason for abandonment of well or producing formation depleted.

If a producing well is abandoned, date of last production 19

Was permission obtained from the Conservation Division or its agents before plugging was commenced? yes

Name of Conservation Agent who supervised plugging of this well Thomas

Producing formation Depth to top Bottom Total Depth of Well 5320 Feet

Show depth and thickness of all water, oil and gas formations.

OIL, GAS OR WATER RECORDS

CASING RECORD

FORMATION	CONTENT	FROM	TO	SIZE	PUT IN	PULLED OUT
				13-3/8	485	none
				5 1/2"	5330	3389

Describe in detail the manner in which the well was plugged, indicating where the mud fluid was placed and the method or methods used in introducing it into the hole. If cement or other plugs were used, state the character of same and depth placed, from feet to feet for each plug set.

Halliburton pumped 2 sacks hulls, 35 sacks cement, followed by plug to 4600'.
Checked bottom, shot pipe at 4000', 3818', 3613', 3524', 3426', pulled 105 joints. Halliburton pumped 65 sacks cement, 10 sacks mud, 20 sacks cement, 2 sacks mud and 15 sacks cement.

PLUGGING COMPLETE.

(If additional description is necessary, use BACK of this sheet)

Name of Plugging Contractor KNIGHT CASING PULLING CO., INC. INC.
Address CHASE, KANSAS

STATE OF KANSAS COUNTY OF RICE, ss.
NOEL J. KNIGHT (employee of owner) or (owner or operator) of the above-described

well, being first duly sworn on oath, says: That I have knowledge of the facts, statements, and matters herein contained and the log of the above-described well as filed and that the same are true and correct. So help me God.

(Signature) Noel Knight
CHASE, KANSAS

Subscribed and sworn to before me this 18th day of November 1975

My commission expires
NOTARY PUBLIC
MARGARET MELCHER
Rice County, Ks.
My Comm. Exp. Feb. 15, 1979

Margaret Melcher
Notary Public.

DRILLERS LOG

LANE ESTATE NO. 1 (OWWO)

WASH DOWN	OPERATOR: Maurice L. Brown Company	DESCRIPTION:
TOTAL DEPTH: 5320'	CONTRACTOR: Sage Drilling Co., Inc.	NE NE NW Sec. 28-29S-21W Ford Co., Kansas
ORIGINAL	COMMENCED: March 19, 1975	
TOTAL DEPTH: 6203'	COMPLETED: March 23, 1975	ELEVATION: 2455KB

<u>FROM</u>	<u>TO</u>	<u>REMARKS</u>
0	5320'	Washed old hole down to 5320 Feet. Conditioned Hole. Set 5½" Casing @ 5330 Feet w/250 sax Cement.

I certify that this is a true and correct copy of the washdown operations on the above captioned well to the best of my knowledge.

SAGE DRILLING CO., INC.

T. M. McCaul, Jr.

By _____
T. M. McCaul, Jr.



Subscribed and sworn to before me this 31st day of March, 1975.

Louise K. Whitted
Louise K. Whitted - Notary Public

My commission expires:
November 26, 1978.

RECEIVED
STATE CORPORATION COMMISSION

NOV 5 1975

CONSERVATION DIVISION
Wichita, Kansas