


STATE OF KANSAS  
STATE CORPORATION COMMISSION

WELL PLUGGING RECORD

Give All Information Completely  
Make Required Affidavit  
Mail or Deliver Report to  
Conservation Division  
State Corporation Comm.  
245 North Water  
Wichita, KS 67202

FORD County. Sec. 8 Twp. 29S Rge. 21W E/W  
Location as "NE/CNW 1/4 SW 1/4" or footage from lines  
C NE SE

Lease Owner PICKRELL DRILLING COMPANY,  
Lease Name FLETCHER "E" Well No. 1  
Office Address 205 LITWIN BLDG., WICHITA, KS. 67202  
Character of Well (Completed as Oil, Gas or Dry Hole)

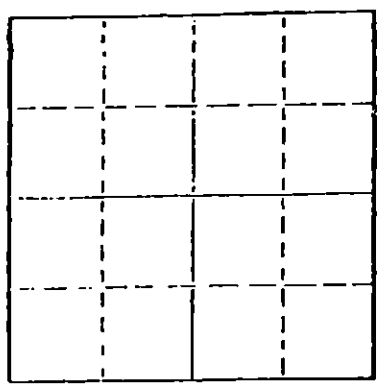

Dry Hole  
Date Well completed 3-12-79 19  
Application for plugging filed 3-12-79 19  
Application for plugging approved 3-12-79 19  
Plugging commenced 3-12-79 19  
Plugging completed 3-12-79 19  
Reason for abandonment of well or producing formation  
Dry Hole

If a producing well is abandoned, date of last production 19

Was permission obtained from the Conservation Division or its agents before plugging was commenced? Yes

Name of Conservation Agent who supervised plugging of this well William T. Owen  
Producing formation Depth to top Bottom Total Depth of Well 5250  
Show depth and thickness of all water, oil and gas formations.

OIL, GAS OR WATER RECORDS

CASING RECORD

FORMATION	CONTENT	FROM	TO	SIZE	PUT IN	PULLED OUT
				8 5/8	533	None

Describe in detail the manner in which the well was plugged, indicating where the mud fluid was placed and the method or methods used in introducing it into the hold. If cement or other plugs were used, state the character of same and depth placed, from feet to feet for each plug set.

50 sacks at 540'  
12 sacks at 40'  
3 sacks in Rat Hole P.D. 5:50am 3-12-79

STATE RECEIVED 3-21-79  
MAR 21 1979  
CONSERVATION DIVISION  
WICHITA, KANSAS

(If additional description is necessary, use BACK of this sheet)  
Name of Plugging Contractor PICKRELL DRILLING COMPANY

STATE OF Kansas COUNTY OF Sedgwick, ss.  
C. W. Sebitts (employee of owner) or (owner or operator)


of the above-described well, being first duly sworn on oath, says: That I have knowledge of the facts, statements, and matters herein contained and the log of the above-described well as filed and that the same are true and correct. So help me God.

BY: C.W. Sebitts  
(Signature) [Signature]  
205 LITWIN BLDG., WICHITA, KS. 67202  
(Address)

SUBSCRIBED AND SWORN TO before me this 15 day of March, 1979

My commission expires 2-18-80

[Signature]  
Jo Ann Sarver  
Notary Public.

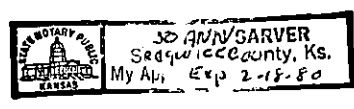

**ROTARY DRILLING LOG**

COMPANY: PICKRELL DRILLING COMPANY  
 205 LITWIN BLDG.  
 WICHITA, KS. 67202  
 LOCATION: FLETCHER "E" #1  
 C NE SE Sec. 8-29S-21W  
 Ford County, Kansas  
 CONTRACTOR: PICKRELL DRILLING COMPANY  
 Wichita, Kansas

Rotary Drilling Commenced 2-28-79  
 Rotary Drilling Completed 3-11-79

CASING RECORD: Spud date 2-28-79 Surf. pipe 8 5/8" set at 533' with 300sx.  
 Comp. 6:15am 2-28-79

**LOG**

(Figures indicate bottom of formation — measurements from top of rotary bushing.)

Topsoil	40
Sand	138
Shale	315
Shale	410
Red Beds	516
Shale	536
Shale	543
Shale	1275
Shale	2145
Shale	2420
Lime & Shale	2510
Lime	2648
Lime	2735
Lime & Shale	2915
Lime & Shale	3082
Lime & Shale	3210
Lime & Shale	3375
Lime & Shale	3535
Lime & Shale	3695
Lime & Shale	3865
Lime & Shale	4100
Lime & Shale	4265
Lime & Shale	4415
Lime	4502
Lime	4559
Lime & Shale	4630
Lime	4731
Lime	4812
Lime	4884
Lime	4966
Lime	5029
Lime	5097
Lime	5120
Lime	5142
Lime & Shale	5162
Lime	5225
Lime	5250

RECEIVED  
 STATE CORPORATION COMMISSION  
 MAR 21 1979  
 CONSERVATION DIVISION  
 Wichita, Kansas

The undersigned, C. W. Sebitts, Attorney-in-Fact for PICKRELL DRILLING COMPANY, hereby certifies in behalf of said Company, that the above is a true and correct log of the formation encountered in drilling the above well as reflected by the Daily Drilling Reports.

PICKRELL DRILLING COMPANY  
 By [Signature]  
 Attorney-in-Fact  
 C. W. Sebitts

STATE OF KANSAS }  
 COUNTY OF SEDGWICK } ss.:

On this 15 day of March, 1979, before me the undersigned, a Notary Public, in and for

the County and State aforesaid, personally appeared C. W. Sebitts, to me known to be the identical person who subscribed the name of PICKRELL DRILLING COMPANY to the foregoing instrument as its Attorney-in-Fact and acknowledged to me that he executed the same as his free and voluntary act and deed, and as the free and voluntary act and deed of such company, for the uses and purposes therein set forth.

Given under my hand and seal of office the day and year last above written.

My commission expires: 2-18-80

[Signature]  
 Notary Public

Jo Ann Sarver

