

15.151-01191-00-00


STATE OF KANSAS  
STATE CORPORATION COMMISSION.

WELL PLUGGING RECORD

Give All Information Completely  
Make Required Affidavit  
Mail or Deliver Report to  
Conservation Division  
State Corporation Comm.  
245 North Water  
Wichita, KS 67202

Pratt County, Sec. 15 Twp. 29S Rge. 13 N/W  
Location as "NE/CNW $\frac{1}{4}$ SW $\frac{1}{4}$ " or footage from lines  
500' FEL 2140' FNL

Lease Owner W. K. Black, Inc.  
Lease Name Brotar Well No. 2A  
Office Address P.O. Box 801, Pratt, KS 67124  
Character of Well (Completed as Oil, Gas or Dry Hole) Dry Hole

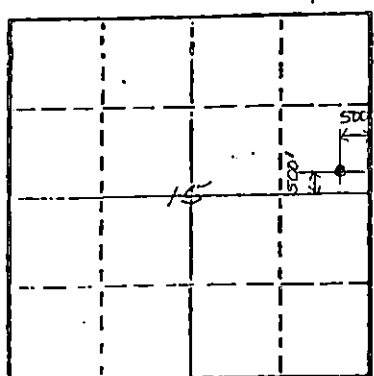

Locate well correctly on above  
Section Plat

Date Well completed 10/20/82 19  
Application for plugging filed 10/20/82 19  
Application for plugging approved 10/20/82 19  
Plugging commenced 10/20/82 19  
Plugging completed 10/20/82 19  
Reason for abandonment of well or producing formation  
Dry Hole

If a producing well is abandoned, date of last production  
N/A 19

Was permission obtained from the Conservation Division or  
its agents before plugging was commenced? Yes

Name of Conservation Agent who supervised plugging of this well Steve Durrant  
Producing formation N/A Depth to top N/A Bottom N/A Total Depth of Well 4780'  
Show depth and thickness of all water, oil and gas formations.

OIL, GAS OR WATER RECORDS

CASING RECORD

FORMATION	CONTENT	FROM	TO	SIZE	PUT IN	PULLED OUT
Brown Lime		3924'		8 5/8"	370'	No
Mississippi		4428'				
Viola		4498'				
Simpson		4616'				
Arbuckle		7732'				

Describe in detail the manner in which the well was plugged, indicating where the mud fluid was placed and the method or methods used in introducing it into the hold. If cement or other plugs were used, state the character of same and depth placed, from 40' feet to 750' feet for each plug set.


Plug to abandon with 115 sacks class A 2% Cacl by Dowell set rubber plug at 750' with 50 sacks. Set plug at 420' cemented with 40 sacks. Set top plug at 40' cemented with 10 sacks. Plug rat hole cemented with 10 sacks. Plug water well with 5 sacks.

(If additional description is necessary, use BACK of this sheet)

Name of Plugging Contractor Dowell

STATE OF Kansas COUNTY OF Pratt, ss.  
William K. Black (operator)

of the above-described well, being first duly sworn on oath, says: That I have knowledge of the facts, statements, and matters herein contained and the log of the above-described well as filed and that the same are true and correct. So help me God.

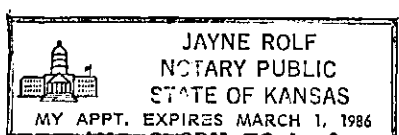

(Signature) [Signature]  
P.O. Box 801, Pratt, KS 67124  
(Address)

SUBSCRIBED AND SWORN TO before me this 21st day of October, 19 82

My commission expires \_\_\_\_\_

[Signature]  
Notary Public.  
STATE CORPORATION COMMISSION

OCT 26 1982

CONSERVATION DIVISION  
Wichita, Kansas