

STATE OF KANSAS
STATE CORPORATION COMMISSION
200 Colorado Derby Bldg.
Wichita, Kansas 67202

WELL PLUGGING RECORD

Give All Information Completely
Make Required Affidavit

COUNTY PRATT SEC. 15 TWP. 29S RGE. 13 EW
Location as in quarters or footage from lines:
C SE NE NE 990' from N line 330' from from E line

Locate Well
correctly on above
Section Platt.

Lease Owner W. K. Black, Inc. & Genoco
Lease Name DeRome Well No. #1A
Office Address P.O. Box 801
Character of Well (~~Completed as Oil, Gas or~~ Dry Hole):
Date Well Completed 12/1/83
Application for plugging filed 12/1/83
Plugging commenced 12/1/83
Plugging completed 12/1/83
Reason for abandonment of well or producing formation

Dry Hole

Was permission obtained from the Conservation Division or it's
Agent's before plugging was commenced? Yes

Name of Conservation Agent who supervised plugging of this well J. H. Metts
Producing formation Dry hole Depth to top _____ bottom T.D. 4762'

Show depth and thickness of all water, oil and gas formations.

OIL, GAS OR WATER RECORDS Casing Record

Formation	Content	From	To	Size	Put in	Pulled Out.
N/A						
ST & C Casing 24#			369'	8 5/8"	9 jts	

Describe in detail the manner in which the well was plugged, indicating where the mud
fluid was placed and the method or methods used in introducing it into the hold. If cement
or other plugs were used, state the character of same and depth placed, from _____ feet
to _____ feet for each plug set.

- 46 sx at 4700'
- 50 sx at 900'
- 10 sx + Bridge Plug at 40' - 0'
- 15 sx in Rat Hole
- 10 sx in Man Hole
- 5 sx in Water Well

Total of 180 sx of 60-40 poz + 2% gel

(If additional description is necessary, use BACK of this sheet)


Name of Plugging Contractor Buie Company

STATE OF Kansas COUNTY OF Pratt, ss.
William K. Black, President (~~employee of owner~~ owner operator) of the
above-described well, being first duly sworn on oath, says: That I have knowledge of the
facts, statements, and matters herein contained and the log of the above-described well as
filed and that the same are true and correct. So help me God.

(Signature) William K. Black
P.O. Box 801, Pratt, KS 67124
(Address)

SUBSCRIBED AND SWORN TO before me this 5th day of December, 1983

My Commission expires:

 

[Signature]
Notary Public.
STATE CORPORATION COMMISSION

RECEIVED
STATE CORPORATION COMMISSION

JAN 10 1984
01-10-84
CONSERVATION DIVISION
Wichita, Kansas