


STATE OF KANSAS
STATE CORPORATION COMMISSION

Give All Information Completely
Make Required Affidavit
Mail or Deliver Report to:
Conservation Division
State Corporation Commission
211 No. Broadway
Wichita, Kansas

WELL PLUGGING RECORD

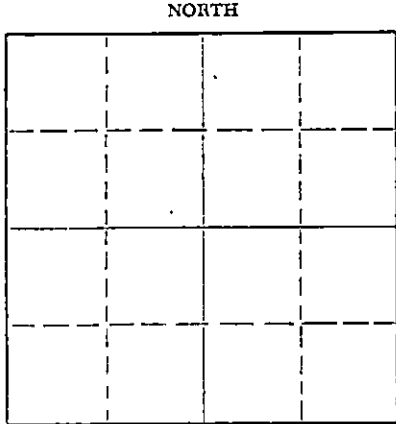

Locate well correctly on above
Section Plat

Pratt County: Sec. 8 Twp. 29S Rge. 12W (E) (W)
Location as "NE/CNW/SW" or footage from lines NE NE SW
Lease Owner T. L. Ferrier
Lease Name Hull Well No. 1
Office Address 300 Schweiter Bldg., Wichita, Kansas
Character of Well (completed as Oil, Gas or Dry Hole) Dry Hole
Date well completed 9/4/66 19
Application for plugging filed 9/4/66 19
Application for plugging approved 9/4/66 19
Plugging commenced 9/4/66 19
Plugging completed 9/4/66 19
Reason for abandonment of well or producing formation Dry

If a producing well is abandoned, date of last production 19
Was permission obtained from the Conservation Division or its agents before plugging was commenced? Yes

Name of Conservation Agent who supervised plugging of this well Archie Elving
Producing formation Depth to top Bottom Total Depth of Well 4675 Feet
Show depth and thickness of all water, oil and gas formations.

OIL, GAS OR WATER RECORDS

CASING RECORD

FORMATION	CONTENT	FROM	TO	SIZE	PUT IN	PULLED OUT
				13-3/8"	256'	0
				8-5/8"	935'	0

Describe in detail the manner in which the well was plugged, indicating where the mud fluid was placed and the method or methods used in introducing it into the hole. If cement or other plugs were used, state the character of same and depth placed, from feet to feet for each plug set.

Heavy mud to 240'. 1/2 sx. hulls, 25 sx. cement.
Mud to 40'. Solid bridge and 10 sx. cement.
Plugged @ 3:00 p.m.

RECEIVED
STATE CORPORATION COMMISSION
SEP 18 1966

CONSERVATION DIVISION
Wichita, Kansas

Name of Plugging Contractor
Address

STATE OF KANSAS, COUNTY OF SEDGWICK, ss.
T. L. Ferrier (employee of owner) or (owner or operator) of the above-described well, being first duly sworn on oath, says: That I have knowledge of the facts, statements, and matters herein contained and the log of the above-described well as filed and that the same are true and correct. So help me God.

(Signature) T. L. Ferrier
300 Schweiter Building, Wichita, Kansas
(Address)

SUBSCRIBED AND SWORN TO before me this 9th day of September, 19 66

March Day
Notary Public.

My commission expires Dec. 14, 1969



DRILLER'S WELL LOG

OPERATOR: T. L. Ferrier
300 Schweiter Building
Wichita, Kansas.

WELL NAME: #1 Hull
LOCATION: NE NE SW Sec. 8-29S-12W
Pratt County, Kansas

CONTRACTOR: **K & E DRILLING, INC.**
719 UNION CENTER BLDG.
WICHITA, KANSAS

COMMENCED: 8/16/66

CASING RECORD:

COMPLETED: 9/4/66

13-3/8" @ 256' w/325 sx.

8-5/8" @ 935' w/975 sx.

ELEVATION:

ROTARY TOTAL DEPTH:
4675'

PRODUCTION: Dry

FORMATION RECORD

Depths shown indicate bottom of formations encountered.

Clay	25
Sand	35
Shale	50
Sand	205
Red Bed, Shale & Shells	610
Sand & Shale	826
Sand	846
Shale	923
Anhydrite	935
Shale & Shells	1700
Lime & Shale	2105
Lime	4493
Lime (hard)	4530
Lime	44522
Hard Sand	4583
Sand	4600
Lime & Sand	4637
Lime	4675

RECEIVED
CORPORATION COMMISSION
SEP-12 1966
CONSERVATION DIVISION
Wichita, Kansas

CERTIFICATION

State of KANSAS }
County of SEDGWICK } ss:

I, Wayne L. Brinegar, of K&E DRILLING, INC., upon oath state that the above and foregoing is a true and correct copy of the Driller's Log of the above named well.

Wayne L. Brinegar
Wayne L. Brinegar

Subscribed and sworn to before me this 8th day of September, 1966

Judie Bickford
Judie Bickford Notary Public.

My Commission expires: 6-8-70

