

STATE OF KANSAS
STATE CORPORATION COMMISSION

WELL PLUGGING RECORD


Give All Information Completely
Make Required Affidavit
Mail or Deliver Report to:
Conservation Division
State Corporation Commission
800 Bittling Building
Wichita, Kansas

OR
FORMATION PLUGGING RECORD

Strike out upper line
when reporting plug-
ging of formations.

PRATT County, Sec. 7 Twp. 29S Rge. (E) 12 (W)

Location as "NE 1/4 NW 1/4 SW 1/4" or footage from lines, SE SE SW
Lease Owner Shell Oil Co., Inc.
Lease Name B. Stoops Well No. 1
Office Address Box 744, Great Bend, Kansas
Character of Well (completed as Oil, Gas or Dry Hole) Dry Hole
Date well completed! Oct. 27 19 43
Application for plugging filed Nov. 2 19 43
Application for plugging approved Nov. 5 19 43
Plugging commenced Nov. 1 19 43
Plugging completed Nov. 2 19 43
Reason for abandonment of well or producing formation Dry Hole

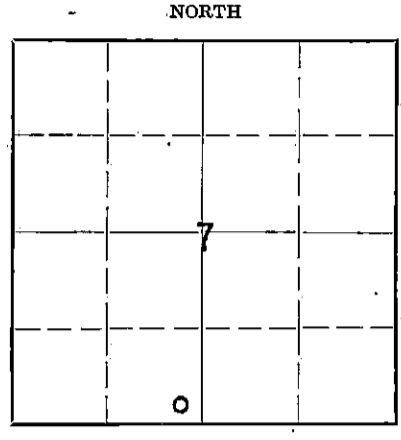

Locate well correctly on above
Section Plat

If a producing well is abandoned, date of last production 19
Was permission obtained from the Conservation Division or its agents before plugging was com-
menced? Yes

Name of Conservation Agent who supervised plugging of this well: C. T. Alexander
Producing formation Arbuckle Depth to top 4679 Bottom Total Depth of Well 4731 Feet
Show depth and thickness of all water, oil and gas formations.

OIL, GAS OR WATER RECORDS

CASING RECORD

Formation	Content	From	To	Size	Put In	Pulled Out
Arbuckle	366' thick mud & 549' mud cut with saltwater in 30 minute drill stem test.	4682	4731	8 5/8"	953	None

Describe in detail the manner in which the well was plugged, indicating where the mud fluid was placed and the method or methods used in introducing it into the hold. If cement or other plugs were used, state the character of same and depth placed, from feet to feet for each plug set.

Filled hole with heavy mud from 4731' to 300'.
Cemented from 300' to 270' with 15 sacks. Mudded
hole from 270' to 26' and capped into cellar with
10 sacks cement.

PLUGGING
FILE 7-29-12
BOOK PAGE 97 LINE 24

STATE CORPORATION
COMMISSION
NOV 17 1943
11-10-43

(If additional description is necessary, use BACK of this sheet)

Correspondence regarding this well should be addressed to Shell Oil Co., Inc.
Address c/o W. M. Gholson, Box 744, Great Bend, Kansas

STATE OF KANSAS COUNTY OF BARTON, ss.
W. M. Gholson (employee of owner)

being first duly sworn on oath, says: That I have knowledge of the facts, statements, and matters herein contained and the log of the above-described well as filed and that the same are true and correct. So help me God.

(Signature) *W. M. Gholson*

Box 744, Great Bend, Kansas (Address)

SUBSCRIBED AND SWORN to before me this 9th day of November, 1943.

Betty Pestlethwaite
Notary Public.

My commission expires January 24, 1945

Shell, B. Stoops #1
SE SE SW 7-29S-12W
Pratt County, Kansas

0 - 34 surface
262 sand
440 sand, red bed & chert
530 sand & red bed
694 red bed
750 red shale & anhydrite
760 anhydrite
810 red shale & anhydrite
850 anhydrite
880 red shale & anhydrite
953 anhydrite & red bed
1410 sand & shale
1510 salt & shale
1950 salt, shale & sand
1970 sand & shale
2049 lime, sand & shale
2189 sand & shale
2244 lime
2460 lime & shale
2520 lime
2530 shale
2792 lime & shale
3530 shale
3805 lime & shale
3855 sandy lime & anhydrite
3981 sandy lime & shale
3981=3950 SLC

TOP TOPEKA 3308 (correct)
TOP LANS. KANS. CITY 3878 (correct)

CASING RECORD

10 3/4" cem. 953 with 550 sax
4024 lime & shale
4041 lime
4086 lime & shale
4119 lime
4167 shale & lime
4310 lime
TOP MISSISSIPPI 4308
4363 lime & chert
4371 chert
4379 lime & chert
4412 lime & shale
4448 shale
TOP VIOLA 4446
4518 lime & chert
4587 lime & shale
4596 lime
4599 lime & shale
4601 lime
4643 lime & shale
4654 sand & shale
4670 sand & lime
4692 lime & shale
4697 Cored & recovered 2 1/2' dolomite,
scattered good porosity, no shows.
TOP ARBUCKLE DOLOMITE 4679 (corrected)
4732 dolomite
4732=4731 SLC TD

STATE OF KANSAS, COUNTY OF BARTON, ss.

W. M. Gholson, employee of owner of the above-described well, being first duly sworn on oath, says: That I have knowledge of the facts, statements, and matters herein contained and the log of the above-described well as filed and that the same are true and correct. So help me God.

Subscribed and sworn to before me this 3rd day of November, 1943.

W. M. Gholson
STATE OF KANSAS
BARTON COUNTY
Notary Public
4-1543

My Commission Expires:
January 24, 1945.

PLUMBING
FILL 7 29 124
BOOK PAGE 97 24