

STATE OF KANSAS  
STATE CORPORATION COMMISSION

Form CP-4


Give All Information Completely  
Make Required Affidavit  
Mail or Deliver Report to:  
Conservation Division  
State Corporation Commission  
211 No. Broadway  
Wichita, Kansas

WELL PLUGGING RECORD

Pratt County. Sec. 23 Twp. 29S Rge. 11W (EX) (W)

Location as "NE/CNW%SW%" or footage from lines NW NW SW  
Lease Owner McClure Oil Company  
Lease Name Inslee Well No. 1  
Office Address 1301 Wichita Plaza, Wichita, Kansas  
Character of Well (completed as Oil, Gas or Dry Hole) Dry Hole  
Date well completed July 24, 19 66  
Application for plugging filed July 24, 19 66  
Application for plugging approved July 24, 19 66  
Plugging commenced July 24, 19 66  
Plugging completed July 24, 19 66  
Reason for abandonment of well or producing formation Dry Hole

NORTH

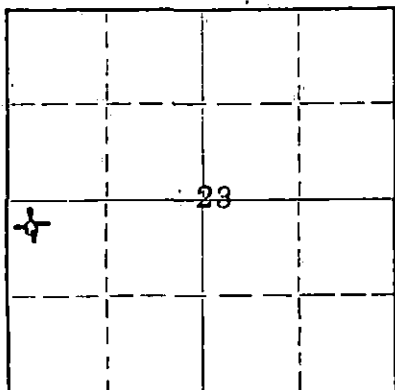

Locate well correctly on above  
Section Flat

If a producing well is abandoned, date of last production \_\_\_\_\_ 19\_\_\_\_  
Was permission obtained from the Conservation Division or its agents before plugging was commenced? Yes

Name of Conservation Agent who supervised plugging of this well Archie Elving  
Producing formation \_\_\_\_\_ Depth to top \_\_\_\_\_ Bottom \_\_\_\_\_ Total Depth of Well \_\_\_\_\_ Feet  
Show depth and thickness of all water, oil and gas formations.

OIL, GAS OR WATER RECORDS

CASING RECORD

FORMATION	CONTENT	FROM	TO	SIZE	PUT IN	PULLED OUT
		0'	412'	8-5/8"		

APPROVED  
STATE CORPORATION COMMISSION  
AUG 1 1966  
CONSERVATION DIVISION  
Wichita, Kansas

Describe in detail the manner in which the well was plugged, indicating where the mud fluid was placed and the method or methods used in introducing it into the hole. If cement or other plugs were used, state the character of same and depth placed, from \_\_\_\_\_ feet to \_\_\_\_\_ feet for each plug set.

4691'-300' Mud  
300'-296' Plug  
296'-256' Cement, 25 sacks  
256'- 40' Mud  
40'- 36' Plug  
36'- 6' Cement, 10 sacks & 1/2 sack hulls  
(Bottom of cellar)

(If additional description is necessary, use BACK of this sheet)

Name of Plugging Contractor Halliburton Cementing Co.  
Address Great Bend, Kansas

STATE OF KANSAS COUNTY OF SEDGWICK, ss.  
John H. Knightley (employee of owner) or (owner or operator) of the above-described


well, being first duly sworn on oath, says: That I have knowledge of the facts, statements, and matters herein contained and the log of the above-described well as filed and that the same are true and correct. So help me God.

(Signature) John H. Knightley  
301 S. Broadway, Wichita, Kansas  
(Address)

Sworn to before me this 27th day of July, 19 66

March 12, 1967

Stella J. Lippa  
Notary Public.

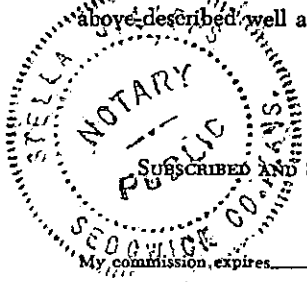

McClure Oil Company

Inslee #1

NW NW SW Sec. 23-29S-11W  
Pratt County, Kansas

Commenced: July 12, 1966

Completed: July 25, 1966

Rotary Drilling Contractor: D. R. Lauck Oil Company, Inc.

Casing Record: 412' 8-5/8" Cemented with 320 sacks Cement,  
2% Calcium Chloride.

Elevation: GR 1794; DF 1797; KB 1799.

Drillers Log

Surface clay, sand & shale	90
Sand	150
Shale & shell	1175
Shale, red bed & shell with lime streaks	1685
Lime & shale	1885
Shale & lime	1950
Lime	2039
Lime with shale streaks	2250
Shale & lime	2435
Lime & shale	2735
Shale & lime	3343
Lime	3485
Lime & shale	3655
Shale & lime	3775
Lime	3855
Lime, Lansing	3915
Lime	4335
Lime & shale	4390
Shale & lime	4430
Lime & shale	4570
Lime (cherty) & shale	4585
Lime & shale	4630
Shale & lime	4655
Shale	4663
Sand	4666
Sand & chert.	4691 RTD

RECEIVED  
STATE CORPORATION COMMISSION

AUG 1 1966

CONSERVATION DIVISION  
Wichita, Kansas