


STATE OF KANSAS  
STATE CORPORATION COMMISSION

Form CP-4

Give All Information Completely  
Make Required Affidavit  
Mail or Deliver Report to:  
Conservation Division  
State Corporation Commission

WELL PLUGGING RECORD

P. O. Box 17027  
Wichita, Kansas 67217  
NORTH

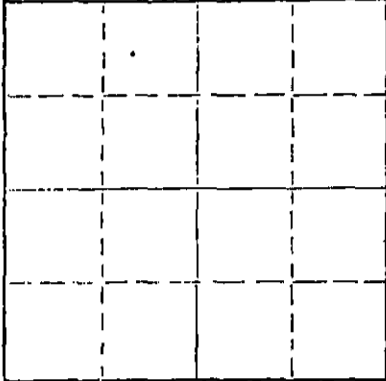

Locate well correctly on above  
Section Plat

Pratt County, Sec. 29 Twp. 29S Rge. 11W (E) (W)  
Location as "NE/CNW/SW" or footage from lines C NW SE  
Lease Owner Davies & Fitzgerald  
Lease Name Blackwelder Well No. 1  
Office Address 1303 Philtower Bldg., Tulsa, Oklahoma  
Character of Well (completed as Oil, Gas or Dry Hole) D & A  
Date well completed May 26 19 74  
Application for plugging filed May 26 19 74  
Application for plugging approved May 26 19 74  
Plugging commenced May 26 19 74  
Plugging completed May 26 19 74  
Reason for abandonment of well or producing formation D & A

If a producing well is abandoned, date of last production 19  
Was permission obtained from the Conservation Division or its agents before plugging was commenced? Yes

Name of Conservation Agent who supervised plugging of this well Bieberstien  
Producing formation Depth to top Bottom Total Depth of Well 4310 Feet  
Show depth and thickness of all water, oil and gas formations.

OIL, GAS OR WATER RECORDS

CASING RECORD

FORMATION	CONTENT	FROM	TO	SIZE	PUT IN	PULLED OUT
				8 5/8	357	-0-

Describe in detail the manner in which the well was plugged, indicating where the mud fluid was placed and the method or methods used in introducing it into the hole. If cement or other plugs were used, state the character of same and depth placed, from feet to feet for each plug set.

Plugged w/35 sx @ 250',  
15 sx @ 40', 2 sx in  
rathole.

RECEIVED  
STATE CORPORATION COMMISSION  
MAY 31 1974  
CONSERVATION DIVISION  
Wichita, Kansas

(If additional description is necessary, use BACK of this sheet)  
Name of Plugging Contractor B & B Drilling, Inc.  
Address 720 Union Center, Wichita, Kansas

STATE OF KANSAS, COUNTY OF SEDGWICK, ss.  
Bill Lahar (employee of owner) or (owner or operator) of the above-described

well, being first duly sworn on oath, says: That I have knowledge of the facts, statements, and matters herein contained and the log of the above-described well as filed and that the same are true and correct. So help me God.

(Signature) Bill Lahar  
Bill Lahar  
720 Union Center, Wichita, Kansas  
(Address)

SUBSCRIBED AND SWORN to before me this 26th day of May, 19 74

My commission expires January 29, 1977  
Betty M. Maloney Notary Public

RECEIVED  
STATE CORPORATION COMMISSION

MAY 31 1974

CONSERVATION DIVISION  
Wichita, Kansas

May 28, 1974

DRILLERS LOG

#1 Blackwelder  
C NW SE, Sec. 29-29S-11W  
Pratt County, Kansas

OPERATOR: Davies & Fitzgerald  
CONTRACTOR: B & B Drilling, Inc.  
COMMENCED: May 17, 1974  
COMPLETED: May 26, 1974

8 5/8" @ 357' w/250 sx

0	365	Surface	
365	500	Redbed & Shale	
500	1700	Shale	
1700	3703	Lime & Shale	
3703	3810	Lime	
3810	3845	Lime & Shale	
3845	4310	Lime	
4310		RTD	D&A

We certify that the above and foregoing is a true and correct copy of the log on the #1 Blackwelder located in Pratt County, Kansas.

B & B DRILLING, INC.

Bill Lahar  
Bill Lahar

Subscribed and sworn to before me this 28th day of May, 1974.

Betty M. Maloney  
Betty M. Maloney Notary Public

My Commission Expires:

January 29, 1977