


STATE OF KANSAS  
STATE CORPORATION COMMISSION

WELL PLUGGING RECORD

Give All Information Completely  
Make Required Affidavit  
Mail or Deliver Report to  
Conservation Division  
State Corporation Comm.  
245 North Water  
Wichita, KS 67202

Pratt County. Sec. 28 Twp. 29S Rge. 11 W E/W  
Location as "NE/CNW 1/4 SW 1/4" or footage from lines  
NE SE NE

Lease Owner F. G. Holl  
Lease Name Cochran #1-28 Well No. 1-28  
Office Address 6427 East Kellogg, Wichita, Kansas 67207  
Character of Well (Completed as Oil, Gas or Dry Hole) Dry Hole

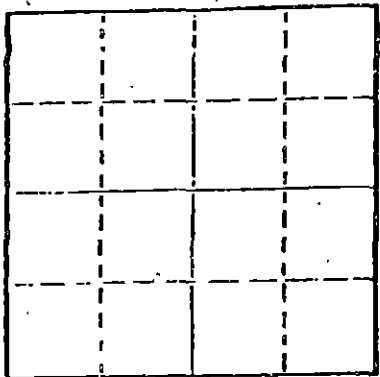

Locate well correctly on above  
Section Plot

Date Well completed October 25, 1978 19  
Application for plugging filed October 25, 1978 19  
Application for plugging approved October 25, 1978 19  
Plugging commenced 3:25 PM October 25, 1978 19  
Plugging completed 4:30 PM October 25, 1978 19  
Reason for abandonment of well or producing formation Dry Hole

If a producing well is abandoned, date of last production 19

Was permission obtained from the Conservation Division or its agents before plugging was commenced? Yes

Name of Conservation Agent who supervised plugging of this well Bill Owens  
Producing formation \_\_\_\_\_ Depth to top \_\_\_\_\_ Bottom \_\_\_\_\_ Total Depth of Well 2800'  
Show depth and thickness of all water, oil and gas formations.

OIL, GAS OR WATER RECORDS

CASING RECORD

FORMATION	CONTENT	FROM	TO	SIZE	PUT IN	PULLED OUT
				7"	265'	None

Describe in detail the manner in which the well was plugged, indicating where the mud fluid was placed and the method or methods used in introducing it into the hold. If cement or other plugs were used, state the character of same and depth placed, from \_\_\_\_\_ feet to \_\_\_\_\_ feet for each plug set.

Filled hole with heavy mud.  
Heavy mud to 480' with 30 sacks  
through drill pipe; heavy mud to 240'  
with 25 sacks through drill pipe; heavy  
mud to 40' with Howco plug, 1/4 sack hulls  
and solid bridge at 40'. 10 sacks to surface.

(If additional description is necessary, use BACK of this sheet)

Name of Plugging Contractor STERLING DRILLING COMPANY  
P. O. Box 129, Sterling, Kansas 67579

STATE OF KANSAS COUNTY OF RICE ss.  
F. A. Wuellner (employee of owner) or (owner or operator) of the above-described well, being first duly sworn on oath, says: That I have knowledge of the facts, statements, and matters herein contained and the log of the above-described well as filed and that the same are true and correct. So help me God. STERLING DRILLING COMPANY

(Signature) [Signature]  
F. A. Wuellner, Secretary  
P. O. Box 129, Sterling, Kansas 67579  
(Address)

Subscribed and sworn to before me this 26th day of October, 19 78

My commission expires \_\_\_\_\_

[Signature]  
Charles M. Hall, Notary Public.

RECEIVED  
STATE CORPORATION COMMISSION

NOV - 6 1978

CONSERVATION DIVISION  
Wichita, Kansas

STERLING DRILLING COMPANY  
P. O. Box 129  
Sterling, Kansas 67579

WELL LOG - - - - - COCHRAN #1-28  
Located: NE SE NE, Section 28-29S-11W, Pratt County,  
Kansas

OWNER: F. G. Holl  
ROTARY DRILLING CONTRACTOR: Sterling Drilling Company

COMMENCED: October 20, 1978  
COMPLETED: October 25, 1978

TOTAL DEPTH: 2800'

<u>LOG</u>	<u>CASING RECORD</u>
0 - 192 Clay, Sand	Ran 8 joints 7" OD casing, 268.05' set at 265 G.L. Cemented with 125 sacks 60/40 Pozmix with 2% gel and 3% cc.
192 - 1282 Shale	Plug down at 6:30 PM, 10-20-78, by Howco.
1282 - 2230 Shale and Lime	
2230 - 2324 Shale	
2324 - 2800 Lime and Shale	Plugged.

RECEIVED  
STATE CORPORATIONS COMMISSION

NOV - 6 1978

CONSERVATION DIVISION  
Wichita, Kansas