


STATE OF KANSAS
STATE CORPORATION COMMISSION

WELL PLUGGING RECORD

Give All Information Completely
Make Required Affidavit
Mail or Deliver Report to:
Conservation Division
State Corporation Commission
800 Bitting Building
Wichita, Kansas

Pratt County, Sec. 12 Twp. 28 Rge. 15 (E) (W)

Location as "NE/CNW $\frac{1}{4}$ SW $\frac{1}{4}$ " or footage from lines NW NW SW
Lease Owner Iron Drilling Company
Lease Name Rezeau Well No. 1
Office Address 1206 Philtower Building
Character of Well (completed as Oil, Gas or Dry Hole) Dry Hole
Date well completed Oct. 6, 19 51
Application for plugging filed Oct. 6 19 51
Application for plugging approved Oct. 6 19 51
Plugging commenced Oct. 6 19 51
Plugging completed Oct. 6 19 51
Reason for abandonment of well or producing formation Dry Hole

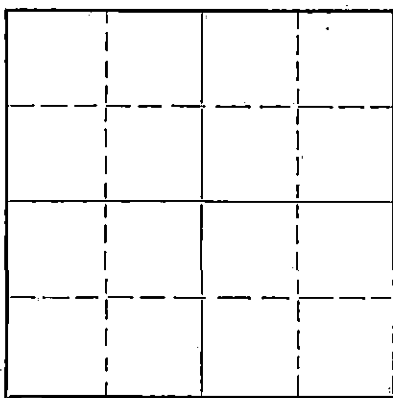

Locate well correctly on above Section Plat

If a producing well is abandoned, date of last production 19...
Was permission obtained from the Conservation Division or its agents before plugging was commenced? Yes

Name of Conservation Agent who supervised plugging of this well G. D. Stough
Producing formation Depth to top Bottom Total Depth of Well Feet
Show depth and thickness of all water, oil and gas formations.

OIL, GAS OR WATER RECORDS

CASING RECORD

Formation	Content	From	To	Size	Put In	Pulled Out
Conglorate		4451		XXR		
Mississippi		4460		8-5/8	270	None
Kinderhook		4473				
Viola		4516				
Simpson Shale		4653				
Arbuckle		4748				

Describe in detail the manner in which the well was plugged, indicating where the mud fluid was placed and the method or methods used in introducing it into the hole. If cement or other plugs were used, state the character of same and depth placed, from...feet to...feet for each plug set.

Filled hole with heavy mud
Bottom Plug set at 270 feet cemented with 15 sacks of cement
Top Plug set at 35 feet cemented with 10 sacks of cement

W. B. G. W. I. D. A.
STATE CORPORATION COMMISSION
OCT 13 1951 10-13-51
CONSERVATION DIVISION
WICHITA, KANSAS

(If additional description is necessary, use BACK of this sheet)

Correspondence regarding this well should be addressed to Iron Drilling Company
Address 1206 Philtower Building, Tulsa, Oklahoma.

STATE OF Oklahoma, COUNTY OF Tulsa, ss.

Herrick Babcock (employee of owner) of (owner or operator) of the above-described well, being first duly sworn on oath, says: That I have knowledge of the facts, statements, and matters herein contained and the log of the above-described well as filed and that the same are true and correct. So help me God.

(Signature) Herrick Babcock
1206 Philtower Building, Tulsa, Oklahoma.
(Address)

SUBSCRIBED AND SWORN to before me this 11th day of October, 19 51

LaDelle Smith
Notary Public.

My commission expires 6-6-52

PLUGGING
FILE SEC 12-28-1152
BOOK PAGE 115-118

DRILLING RECORD

Well No. 1 Rezeau
 Located: NW NW SW
 Section 12-28-15W
 Pratt County, Kansas

Casing Record

270' - 8-5/8" OD SS Casing cemented
 w/200 sacks of cement

Work Commenced 9/13/51
 Drilling Commenced 9/14/51
 Drilling Completed 10/5/51
 Work Completed 10/6/51

No Oil String run - Dry Hole

	WELL	LOG
Surface clay sand & shale	0 to	260
Red Beds	260 to	300
Sand	300 to	600
Red Beds	600 to	750
Sahel & Red Beds	750 to	860
Anhydrite	860 to	885
Shale & Shells	885 to	900
Shale	900 to	1330
Shale & Shells	1330 to	1850
Shale, Sand & Lime	1850 to	2100
Lime	2100 to	2170
Lime & Shale	2170 to	2730
Shale & Salt	2730 to	2780
Shale & Lime	2780 to	3600
Lime	3600 to	3875
Lime & Shale	3875 to	3915
Lime	3915 to	4399
Lime & Shale	4399 to	4426
Lime	4426 to	4527
Chert & Lime	4527 to	4546
Lime & Shale	4546 to	4661
Lime	4661 to	4681
Lime & shale	4681 to	4748
Lime	4748 to	4801 TD

Certification

State of Oklahoma
 County of Tulsa, SS

I, Herrick Babcock, of the Iron Drilling Company, Certify that
 the above is a true and correct log of the above described well.

Signed Herrick Babcock

Subscribed to and Sworn before me this 11th day of October, 1951.

PLATTING
 FILE SEC-1478 R150
 BOOK PAGE 115 LINE 18
 My commission expires 6-6-52

J. D. Smith
 Notary Public

OCT 13 1951

COMMISSION DIVISION
 Wichita, Kansas