


WELL PLUGGING RECORD

Give All Information Completely
Make Required Affidavit
Mail or Deliver Report to:
Conservation Division
State Corporation Commission
211 No. Broadway
Wichita, Kansas

Pratt County. Sec. 12 Twp. 28 Rge. 15 (E) (W) *
Location as "NE/CNW&SW&" or footage from lines NW NW SW
Lease Owner J. E. Newman
Lease Name Rezeau Well No. 1
Office Address Suite 2005 Tower Bldg., Denver 2, Colorado
Character of Well (completed as Oil, Gas or Dry Hole) Dry hole
Date well completed June 3 1963
Application for plugging filed About May 21 1963
Application for plugging approved About May 26 1963
Plugging commenced June 1 1963
Plugging completed June 3 1963
Reason for abandonment of well or-producing formation Dry hole

NORTH

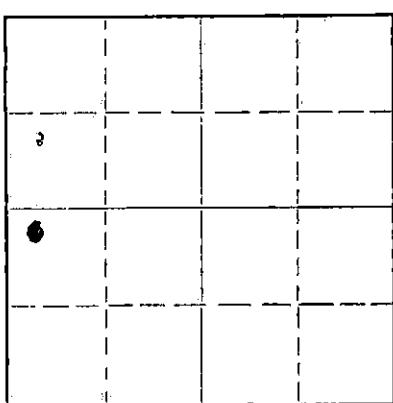

Locate well correctly on above
Section Plat

If a producing well is abandoned, date of last production none 19
Was permission obtained from the Conservation Division or its agents before plugging was commenced? Yes

Name of Conservation Agent who supervised plugging of this well Mr. Archie Elving
Producing formation Cherokee Sand Depth to top 4476 Bottom 4486 Total Depth of Well 4799 Feet
Show depth and thickness of all water, oil and gas formations.

OIL, GAS OR WATER RECORDS

CASING RECORD

| FORMATION | CONTENT | FROM | TO | SIZE | PUT IN | PULLED OUT |
|-----------|--|------|----|----------------------|--------|------------|
| | Note: Electric log was filed with the plugging application | | | | | |
| | | | | 2 1/2" up-set tubing | 4550' | 2527' |
| | | | | | | |
| | | | | | | |

Describe in detail the manner in which the well was plugged, indicating where the mud fluid was placed and the method or methods used in introducing it into the hole. If cement or other plugs were used, state the character of same and depth placed, from _____ feet to _____ feet for each plug set.

268' of 8 5/8" surface pipe, cement circulated. 4550' of 2 1/2" tubing for long string, cemented with 100 sacks. Top perforation 4476'. Hole was squeezed to 3730' with 35 sacks cement by Halliburton Cementing Co. Fluid level was up in hole, 3 sacks cement was mixed and set on plug, through dump bailer, at 240' with 10' rock bridge, let set overnight, next morning hole bailed down, 17 sacks cement was added to plug. Hole was filled with mud to 40', 10' rock bridge, cemented with 10 sacks to base cellar. 2527' of 2 1/2" tubing, as long string was recovered from hole.

RECEIVED
STATE CORPORATION COMMISSION

JUN 25 1963
6-25-1963

CONSERVATION DIVISION
Wichita, Kansas

(If additional description is necessary, use BACK of this sheet)

Name of Plugging Contractor Cherokee Drilling & Exploration
Address Suite 2005 Tower Building, Denver 2, Colorado

STATE OF Kansas, COUNTY OF Pratt, ss.
B. Y. Newman (employee of owner) or (owner or operator) of the above-described well, being first duly sworn on oath, says: That I have knowledge of the facts, statements, and matters herein contained and the log of the above-described well as filed and that the same are true and correct. So help me God.

(Signature) B. Y. Newman
1500 East First St Pratt Kansas
(Address)

SUBSCRIBED AND SWORN to before me this 23 day of June, 1963

My commission expires Feb. 15, 1967
Sandra J. Halzman Notary Public.

