


STATE OF KANSAS
STATE CORPORATION COMMISSION

Form CP-4

Give All Information Completely
Make Required Affidavit
Mail or Deliver Report to:
Conservation Division
State Corporation Commission
212 No. Market
Wichita, Kansas

WELL PLUGGING RECORD

NORTH

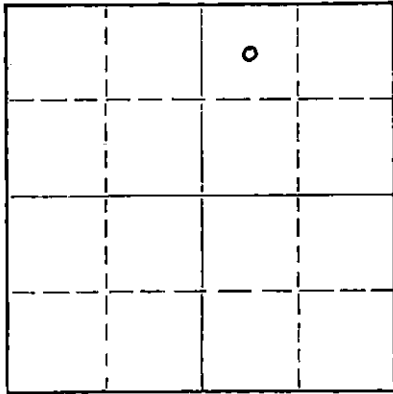

Locate well correctly on above
Section Plat

Pratt County, Sec. 12 Twp. 28S Rge. XXXX 15(W)

Location as "NE/CNW/SW" or footage from lines C NW NE

Lease Owner PAR Petroleum, Inc.

Lease Name Bunsold Well No. 1

Office Address P.O. Box 280, Liberal, Kansas 67901

Character of Well (completed as Oil, Gas or Dry Hole) D&A

Date well completed Jan. 9, 1979

Application for plugging filed Jan. 15, 1979

Application for plugging approved Jan. 1979

Plugging commenced Jan. 9, 1979

Plugging completed Jan. 9, 1979

Reason for abandonment of well or producing formation No Production Encountered

If a producing well is abandoned, date of last production None 19

Was permission obtained from the Conservation Division or its agents before plugging was commenced? Yes

Name of Conservation Agent who supervised plugging of this well Duane Rankin

Producing formation None Depth to top Bottom Total Depth of Well 4700 Feet

Show depth and thickness of all water, oil and gas formations.

OIL, GAS OR WATER RECORDS

CASING RECORD

FORMATION	CONTENT	FROM	TO	SIZE	PUT IN	PULLED OUT
Surface		0	345'	8-5/8"	345'	None

Describe in detail the manner in which the well was plugged, indicating where the mud fluid was placed and the method or methods used in introducing it into the hole. If cement or other plugs were used, state the character of same and depth placed, from feet to feet for each plug set.

Heavy Drilling Mud 4700' to 540'.
40 Sacks Cement @ 540'
Heavy Drilling Mud 540' to 330'
40 Sacks cement at 330'.
Heavy Drilling Mud 330' to 40'.
12 Sacks Cement 40' to surface.
3 Sacks cement in Rathole
All cement mixed and pumped by Halliburton Pump truck.

RECEIVED
STATE CORPORATION COMMISSION
JAN 23 1979
1-23-1979
CONSERVATION DIVISION
Wichita, Kansas

(If additional description is necessary, use BACK of this sheet)

Name of Plugging Contractor DNB Drilling Co.

Address Wichita, Kansas

STATE OF Kansas, COUNTY OF Seward, ss.
Ralph M. Reynolds (employee of owner) or (owner or operator) of the above-described

well, being first duly sworn on oath, says: That I have knowledge of the facts, statements, and matters herein contained and the log of the above-described well as filed and that the same are true and correct. So help me God.

(Signature) *Ralph M. Reynolds*

P.O. Box 280, Liberal, Kansas 67901

(Address)

SUBSCRIBED AND SWORN TO before me this 15 day of January, 19 79

Georgetta Taylor
Notary Public.

commission expires



DRILLER'S LOG

PAR PETROLEUM, INC.
No. 1 Bunsold
C NW NE Sec. 12-28S-15W
Pratt Co., Ks.

Commenced: 12-30-78
Completed: 1-9-79

Surface Casing: 338' of 8-5/8" cmtd
w/225 sx Class H, 3% cc
12-31-78

<u>FORMATION</u>	<u>DEPTH</u>
Surface Hole	0 - 345
Shale	345 - 372
Shale & Lime	372 - 1095
Shale	1095 - 2025
Lime & Shale	2025 - 2705
Lime & Red Eagle Sand	2705 - 2940
Lime & Shale	2940 - 3980
Shale	3980 - 4134
Lime	4134 - 4395
Shale	4395 - 4497
Lime	4497 - 4700 RTD

RECEIVED
STATE CORPORATION COMMISSION

JAN 18 1979

CONSERVATION DIVISION
Wichita, Kansas

I do hereby certify that the foregoing statements are true and correct to the best of my knowledge and belief.

D. N. B. DRILLING, INC.

Ella Priess
Ella Priess

STATE OF KANSAS: ss:

Subscribed and sworn to before me this 10th day of January, 1979.

Dorothy L. Schmidt
Dorothy L. Schmidt, Notary Public

DOROTHY L. SCHMIDT
STATE NOTARY PUBLIC
Sedgwick County, Kansas
My App. Exp. April 30, 1979