

STATE OF KANSAS
STATE CORPORATION COMMISSION
200 Colorado Derby Bldg.
Wichita, Kansas. 67202

Form CP-4
Rev. 12-15-80

WELL PLUGGING RECORD

Give All Information Completely
Make Required Affidavit

COUNTY PRATT SEC. 12 TWP. 28 RGE. 15w E/W
Location as in quarters or footage from lines:
C NW NE

Lease Owner PAR PETROLEUM INC.
Lease Name BUNSOLD Well No. 1
Office Address BOX 280; LIBERAL, KS. 67901
Character of Well (Completed as Oil, Gas or Dry Hole): OIL
Date Well Completed 9-6-81
Application for plugging filed 2-17-83
Plugging commenced 5-9-83
Plugging completed 5-10-83
Reason for abandonment of well or producing formation DRY

Locate Well
correctly on above
Section Platt.

Was permission obtained from the Conservation Division or it's
Agent's before plugging was commenced? YES

Name of Conservation Agent who supervised plugging of this well RICHARD LACEY
Producing formation _____ Depth to top _____ bottom T.D. 4700'

Show depth and thickness of all water, oil and gas formations.

OIL, GAS OR WATER RECORDS

Casing Record

Formation	Content	From	To	Size	Put in	Pulled Out:
				4 1/2"		1900.45'

Describe in detail the manner in which the well was plugged, indicating where the mud
fluid was placed and the method or methods used in introducing it into the hold. If cement
or other plugs were used, state the character of same and depth placed, from _____ feet
to _____ feet for each plug set.

HALLIBURTON SERVICES CAME OUT AND PUMPED DOWN 35 SACKS OF CEMENT WITH 3 3/8" C.C. AT
TO 4510'

TOP: HALLIBURTON SERVICES PUMPED DOWN 3HULLS ; 10 GELL ; 50 SACKS OF CEMENT ; 10 GELL ;
1 HULL: 85/8" PLUG: 100 SACKS OF CEMENT.

(If additional description is necessary, use BACK of this sheet)


Name of Plugging Contractor H&H CASTING PULLING CO.

STATE OF KANSAS COUNTY OF RENO, ss.

DONALD H. HURST (employee of owner) or (owner or operator) of the
above-described well, being first duly sworn on oath, says: That I have knowledge of the
facts, statements, and matters herein contained and the log of the above-described well as
filed and that the same are true and correct. So help me God.

(Signature) Donald H. Hurst
2900 ACRES RD. APT. 107, HUTCHINSON, KS. 67501
(Address)

SUBSCRIBED AND SWORN TO this 11th day of May, 1983

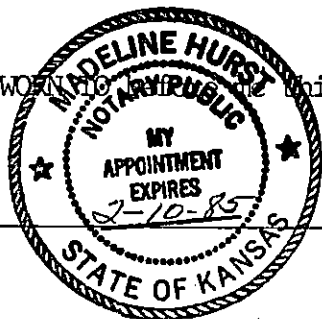

My Commission expires: _____

Madeline Hurst
Notary Public.
STATE CORPORATION COMMISSION

MAY 12 1983

KANSAS

WELL COMPLETION REPORT AND DRILLER'S LOG

COPY

S. 12 T. 28 R. 15 W

Loc. C NW NE

County Pratt

API.No. 15 - 151 - 20597-A
County Number

OWWD

Operator PAR Petroleum, Inc.

Address P. O. Box 280 - Liberal, Kansas 67901

Well No. 1 Lease Name Bunsold


Footage Location 660 feet from (N) XX line 1980 feet from (E) OXX line

Principal Contractor Patrick Well Service Geologist Ralph M. Reynolds

Spud Date 12-30-78 Date Completed 9-6-81 Total Depth 4700' P.B.T.D. 4615'

Directional Deviation Oil and/or Gas Purchaser Derby Refining

640 Acres N

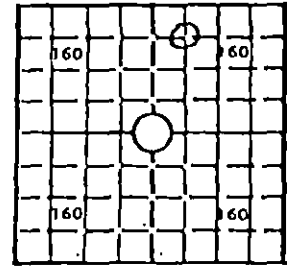

Elev.: Gr. 2049' KB 2051'

CASING RECORD

Report of all strings set—surface, intermediate, production, etc.

Purpose of string	Size hole drilled	Size casing set (in O.D.)	Weight lbs/ft.	Setting depth	Type cement	Sacks	Type and percent additives
Surface	12 1/4"	8 5/8	20	345'	Class 'H'	225	3% CaCl
Production	7 7/8"	4 1/2	10 1/2	4670'	50/50 Posmix	175	18% CaCl

LINER RECORD

PERFORATION RECORD

Top, ft.	Bottom, ft.	Sacks cement	Shots per ft.	Size & type	Depth interval
			Two	0.38" Jet	4496' - 4520'

TUBING RECORD

Size	Setting depth	Packer set at
2 3/8" OD	4500'	

ACID, FRACTURE, SHOT, CEMENT SQUEEZE RECORD

Amount and kind of material used	STATE CORPORATION COMMISSION RECEIVED JAN 20 1983 CONSERVATION DIVISION Wichita, Kansas	Depth interval treated
2000 gal. 7 1/2% De-mud acid		4496' - 4520'
54,000 gal. Gelled Water and 39,400# 20/40 sand		4496' - 4520'

INITIAL PRODUCTION

Date of first production	Producing method (flowing, pumping, gas lift, etc.)
10-1-81	Pumping

RATE OF PRODUCTION PER 24 HOURS	Oil	Gas	Water	Gas-oil ratio
	25 bbls.	TSTM MCF	140 bbls.	0

Disposition of gas (vented, used on lease or sold)	Producing interval (s)
Used on lease	4496' - 4520'

INSTRUCTIONS: As provided in KCC Rule 82-2-125, within 90 days after completion of a well, one completed copy of this Drillers Log shall be transmitted to the State Geological Survey of Kansas, 4150 Monroe Street, Wichita, Kansas 67209. Copies of this form are available from the Conservation Division, State Corporation Commission, 245 No. Water, Wichita, Kansas 67202. Phone AC 316-522-2206. If confidential custody is desired, please note Rule 82-2-125. Drillers Logs will be on open file in the Oil and Gas Division, State Geological Survey of Kansas, Lawrence, Kansas 66044.

DESIGNATE TYPE OF COMP. OIL, GAS, DRY HOLE, SWDW, ETC.:

Operator

Well No.

1

Lease Name

Bunsold

Oil

S 12 T 28 R 15 XX
W

WELL LOG

Show all important zones of porosity and contents thereof; cored intervals, and all drill-stem tests, including depth interval tested, cushion used, time tool open, flowing and shut-in pressures, and recoveries.

SHOW GEOLOGICAL MARKERS, LOGS RUN, OR OTHER DESCRIPTIVE INFORMATION.

FORMATION DESCRIPTION, CONTENTS, ETC.	TOP	BOTTOM	NAME	DEPTH
Surface Hole	0	345	Red Eagle	2,886
Shale	345	372	Indian Cave	3,070
Shale & Lime	372	1,095	Pennsylvanian	3,190
Shale	1,095	2,025	Heebner	3,852
Lime & Shale	2,025	2,705	Brn Lime	3,998
Lime & Red Eagle Sand	2,705	2,940	Lansing	4,022
Lime & Shale	2,940	3,980	Cherokee Sd	4,475
Shale	3,980	4,134	Mississippian	4,492
Lime	4,134	4,395	Kinderhook	4,530
Shale	4,395	4,497	Viola	4,565
Lime	4,497	4,700	Simpson	4,655
		RTD		

RECEIVED
STATE CONSERVATION COMMISSION
JAN 20 1983
CONSERVATION DIVISION
Wichita, Kansas

USE ADDITIONAL SHEETS, IF NECESSARY, TO COMPLETE WELL RECORD.

Date Received

Rodney R. Reynolds
Signature

Vice President

Title

11-4-81

Date