


STATE OF KANSAS
STATE CORPORATION COMMISSION

WELL PLUGGING RECORD

Give All Information Completely
Make Required Affidavit
Mail or Deliver Report to
Conservation Division
State Corporation Comm.
245 North Water
Wichita, KS 67202

Pratt County. Sec. 12 Twp. 29S Rge. 12W E/4
Location as "NE/CNW 1/4 SW 1/4" or footage from lines _____
C-NE NE
Lease Owner PAR Petroleum, Inc.
Lease Name Barker Well No. 1
Office Address P. O. Box 280, Liberal, Kansas 67901
Character of Well (Completed as Oil, Gas or Dry Hole)
Dry Hole
Date Well completed November 15, 1979
Application for plugging filed Verbal Application 1979
Application for plugging approved Verbal Approval 1979
Plugging commenced November 15, 1979
Plugging completed November 15, 1979
Reason for abandonment of well or producing formation _____

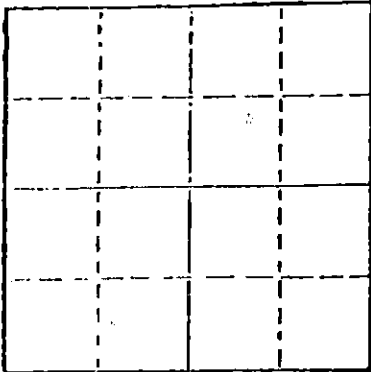

Locate well correctly on above Section Plat

If a producing well is abandoned, date of last production 1979
Was permission obtained from the Conservation Division or its agents before plugging was commenced? Yes

Name of Conservation Agent who supervised plugging of this well Wm. T. Owen
Producing formation _____ Depth to top _____ Bottom _____ Total Depth of Well 3,240'
Show depth and thickness of all water, oil and gas formations.

OIL, GAS OR WATER RECORDS

CASING RECORD

FORMATION	CONTENT	FROM	TO	SIZE	PUT IN	PULLED OUT
				8-5/8"	281'	None

Describe in detail the manner in which the well was plugged, indicating where the mud fluid was placed and the method or methods used in introducing it into the hold. If cement or other plugs were used, state the character of same and depth placed, from _____ feet to _____ feet for each plug set.

Filled hole with heavy rotary mud from 3,240 ft. (rotary total depth) to 420 ft. Set plug at 420 ft. and cemented with 40 sacks cement. Filled hole with heavy rotary mud from 420 ft. to 270 ft. Set plug at 270 ft. and cemented with 40 sacks cement. Filled hole with heavy rotary mud from 270 ft. to 40 ft. Set solid plug at 40 ft. and cemented to cellar with 10 sacks cement, 5 sacks cement in rat hole.

Plugging operations accomplished utilizing Dowell Oil Well cementing pump truck through 4 1/2 inch drill pipe.

(If additional description is necessary, use BACK of this sheet)

Name of Plugging Contractor Dowell Div., Dow Chemical Co.
W. Railroad Ave., Great Bend, Kansas

RECEIVED
STATE CORPORATION COMMISSION

NOV 20 1979


11-27-1979

STATE OF Kansas COUNTY OF Sedgwick
Dean Britting, Agent (Employee of owner) XXXXXXXXXXXXXXXXXXXX

of the above-described well, being first duly sworn on oath, says: That I have knowledge of the facts, statements, and matters herein contained and the log of the above-described well as filed and that the same are true and correct. So help me God.

(Signature) Dean Britting
200 N. Main, Wichita, Kansas 67202
(Address)

SUBSCRIBED AND SWORN TO before me this 26th day of November, 1979

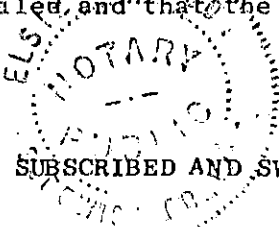

Elsie Willison
Notary Public.

My commission expires July 25, 1982

KANSAS DRILLERS LOG

COMPANY FAR Petroleum, Inc.

SEC. 12 T. 29S R. 12W

FARM Barker NO. 1

LOC. C-NE NE

COUNTY Pratt

ROTARY TOTAL DEPTH 3,240'

COMM. November 7, 1979

COMP. November 15, 1979

CONTRACTOR H-30, Inc. (Rig #7)

ISSUED November 26, 1979

CASING

10 3/4"

8 5/8" Set at 287' cemented w/200 sxs cement

ELEVATION 1,851' G.L.

5 1/2"

4 1/2"

FIGURES INDICATE BOTTOM OF FORMATIONS

Sand, Shale and Red Bed

292'

Red Bed and Shale

1,622'

Lime and Shale

3,240'

Rotary Total Depth

3,240'

I hereby certify the above and foregoing to be a true and correct log of the above described well as shown by the drilling reports.

H-30, INC.

Dean Britting
Dean Britting

State of Kansas }
County of Sedgwick } SS:

Subscribed and Sworn to before me a Notary Public in and for said county and state this 26th day of November, 1979.

Elsie Willison
Elsie Willison - Notary Public

My Commission Expires:
July 25, 1982

RECEIVED
STATE CORPORATION COMMISSION

NOV 27 1979

CONSERVATION DIVISION
Wichita, Kansas