

TYPE

AFFIDAVIT OF COMPLETION FORM

ACO-1 WELL HISTORY

SIDE ONE

Two (2) copies of this form shall be filed with the Kansas Corporation Commission, 200 Colorado Derby Building, Wichita, Kansas 67202, within thirty (30) days after the completion of a well, regardless of how the well was completed.

Attach separate letter of request if the information is to be held confidential. If confidential, only file one copy. Information on Side One will be of public record and Side Two will then be held confidential.

Applications must be made on dual completion, commingling, salt water disposal, injection and temporarily abandoned wells.

Attach one copy only wireline logs (i.e. electrical log, sonic log, gamma ray neutron log, etc.). (Rules 82-2-105 & 82-2-125) KCC# (316) 263-3238.

LICENSE # 5047 EXPIRATION DATE 6/30/83

OPERATOR Rupe Oil Company, Inc. API NO. 15-095-21,317-0000

ADDRESS P. O. Box 2273 COUNTY Kingman

Wichita, Kansas 67201 FIELD Dresden

** CONTACT PERSON W. G. Clement PROD. FORMATION

PHONE 316/262-3748

PURCHASER LEASE Dyche

ADDRESS WELL NO. 1-10

WELL LOCATION C SW SE

DRILLING Aldebaran Drilling Co., Inc. 660 Ft. from West Line and

CONTRACTOR P. O. Box 18611 660 Ft. from South Line of

ADDRESS Wichita, Kansas 67207 the SE (Qtr.) SEC 10 TWP 27S RGE 10W.

PLUGGING Halliburton Services

CONTRACTOR P. O. Box 963

ADDRESS Pratt, Kansas 67124


TOTAL DEPTH 4134 PBTD

SPUD DATE 1/1/83 DATE COMPLETED 1/8/83

ELEV: GR 1757' DF KB 1766'

DRILLED WITH (CABLE) (ROTARY) (AIR) TOOLS.

DOCKET NO. OF DISPOSAL OR REPRESSURING WELL BEING USED TO DISPOSE OF WATER FROM THIS LEASE

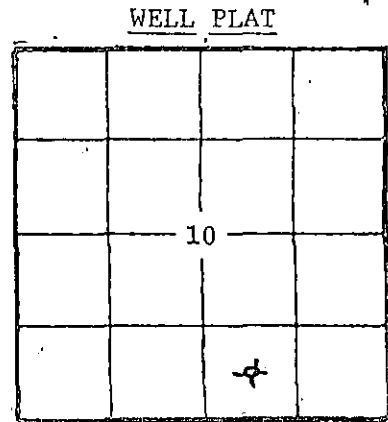

(Office Use Only) KCC KGS SWD/REP PLG.

Amount of surface pipe set and cemented 283' DV Tool Used? No

THIS AFFIDAVIT APPLIES TO: (Circle ONE) - Oil, Gas, Shut-in Gas, Dry Disposal, Injection, Temporarily Abandoned, OWWO. Other

ALL REQUIREMENTS OF THE STATUTES, RULES AND REGULATIONS PROMULGATED TO REGULATE THE OIL AND GAS INDUSTRY HAVE BEEN FULLY COMPLIED WITH.

FEB 4 1983 2-4-1983

A F F I D A V I T

William G. Clement, being of lawful age, hereby certifies

that:

I am the Affiant, and I am familiar with the contents of the foregoing Affidavit. The statements and allegations contained therein are true and correct.

William G. Clement (Name)

SUBSCRIBED AND SWORN TO BEFORE ME this 31st day of January



Faye W. Leach (NOTARY PUBLIC)

** The person who can be reached by phone regarding any questions concerning this information.

FILL IN WELL INFORMATION AS REQUIRED:

WELL NO. 1-10

Show all important zones of porosity and contents thereof; corod intervals, and all drill-stem tests, including depth interval tested, cushion used, time tool open, flowing and shut-in pressures, and recoveries.			SHOW GEOLOGICAL MARKERS, LOGS RUN, OR OTHER DESCRIPTIVE INFORMATION.	
FORMATION DESCRIPTION, CONTENTS, ETC.	TOP	BOTTOM	NAME	DEPTH
DST #1 3555-82' 30"-45"-45"-60" Rec. 60' drilling mud. IF 29-39# FP 39-39# ISIP 79# FSIP 119#			Indian Cave	2402'
DST #2 4006-4026' 30"-45"-45"-60" Rec. 40' Muddy Water. IF 29-29# FP 29-29# ISIP 798# FSIP 1048#			Tarkio	2673'
DST #3 4028-36' Misrun			Heebner	3351'
DST #4 4027-46' 30"-55"-60"-90" Rec. 62' Drilling Mud and 62' very slightly Oil Cut Mud. IF 49-59#, FP 49-59#, ISIP 918#, FSIP 1158# RTD 4134' No E. Log run.			Brown Lime	3501'
			Lansing	3512'
			B/K.C.	3905'
			Cgl. Sand	4017'
			Miss.	4028'
			Kinderhook	4118'
			RTD	4134'

RELEASED
FEB 01 1984
FROM CONFIDENTIAL

Report of all strings set— surface, intermediate, production, etc. CASING RECORD (New) or (Used)

Purpose of string	Size hole drilled	Size casing set (in O.D.)	Weight lbs/ft.	Setting depth	Type cement	Sacks	Type and percent additives
Surface	12 1/4"	8 5/8"	20#	283'	Common	225	2% Gel & 3% Calc Chloride

LINER RECORD			PERFORATION RECORD		
Top, ft.	Bottom, ft.	Sacks cement	Shots per ft.	Size & type	Depth interval

TUBING RECORD		ACID, FRACTURE, SHOT, CEMENT SQUEEZE RECORD	
Size	Setting depth	Packer set at	Amount and kind of material used

Date of first production		Producing method (flowing, pumping, gas lift, etc.)		Gravity	
Estimated Production -I.P.	Oil bbls.	Gas MCF	Water %	Gas-oil ratio	CFPB
Disposition of gas (vented, used on lease or sold)			Perforations		