

STATE CORPORATION COMMISSION OF KANSAS
OIL & GAS CONSERVATION DIVISION

WELL COMPLETION OR RECOMPLETION FORM
ACO-1 WELL HISTORY

DESCRIPTION OF WELL AND LEASE

Operator: License # 9158
Name Case Oil & Gas, Inc.
Address 110 S. Main
P.O. Box 8564
City/State/Zip Pratt, KS 67124

Operator Contact Person Stan Case
Phone (316) 672-9347

Contractor: License # 5829
Name Aldebaran Drilling Co., Inc.

Wellsite Geologist Michael W. Bair
Phone (913) 483-6393
D & A

PURCHASER.....

Designate Type of Completion

New Well Re-Entry Workover

Oil D & A SWD Temp Abd
 Gas Inj Delayed Comp.
 Dry Other (Core, Water Supply etc.)
K-K-K

If ONWO: old well info as follows:

Operator
Well Name
Comp. Date Old Total Depth.....

WELL HISTORY

Drilling Method:

Mud Rotary Air Rotary Cable

.5-22-85. ...6-01-85.. .6-01-85...
Spud Date Date Reached TD Completion Date
4878 4878
.....
Total Depth PBTD

Amount of Surface Pipe Set and Cemented at 411 feet

Multiple Stage Cementing Collar Used? Yes No
If yes, show depth set.....feet

If alternate 2 completion, cement circulated
from.....feet depth to.....w/.....SX cmt

API NO. 15-097-21,139-0000

County Kiowa

C. N/2 NE NW Sec. 35 Twp. 27 Rge. 16 East West

4950 Ft North from Southeast Corner of Section
3355 Ft West from Southeast Corner of Section

(Note: Locate well in section plat below)


Lease Name November Well # 1

Field Name Wildcat

Producing Formation D & A

Elevation: Ground 2088 KB 2096

Section Plat

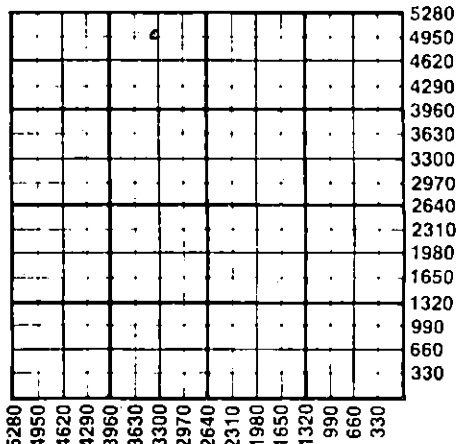

WATER SUPPLY INFORMATION

Source of Water:
Division of Water Resources Permit #

Groundwater.....Ft North from Southeast Corner
(Well)Ft West from Southeast Corner of
Sec Twp Rge East West

Surface Water.....Ft North from Southeast Corner
(Stream, pond etc).....Ft West from Southeast Corner
Sec Twp Rge East West

Other (explain)
(purchased from city, R.W.D.#)

Disposition of Produced Water: Disposal Repressuring

Docket #

INSTRUCTIONS: This form shall be completed in duplicate and filed with the Kansas Corporation Commission, 200 Colorado Derby Building, Wichita, Kansas 67202, within 90 days after completion or recompletion of any well. Rule 82-3-130 and 82-3-107 apply.

Information on side two of this form will be held confidential for a period of 12 months if requested in writing and submitted with the form. See rule 82-3-107 for confidentiality in excess of 12 months. One copy of all wireline logs and drillers time log shall be attached with this form. Submit CP-4 form with all plugged wells. Submit CP-111 form with all temporarily abandoned wells.


All requirements of the statutes, rules and regulations promulgated to regulate the oil and gas industry have been fully complied with and the statements herein are complete and correct to the best of my knowledge.

Signature *Robert W. Houchette*

Title Controller Date 8-7-85

Subscribed and sworn to before me this 7th day of August 1985

Notary Public *Joyce Parker*
Date Commission Expires May 7, 1988

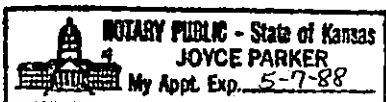

K.C.C. OFFICE USE ONLY
 Letter of Confidentiality Attached
 Wireline Log Received
 Drillers Timelog Received
Distribution
 KCC SWD/Rep NGPA
 KGS Plug Other
(Specify)
RECEIVED
STATE CORPORATION COMMISSION

SIDE TWO

Operator Name Case Oil & Gas Lease Name November Well # 1 SEC. 35 TWP. 27 RGE. 16 East West

WELL LOG

INSTRUCTIONS: Show important tops and base of formations penetrated. Detail all cores. Report all drill stem tests giving interval tested, time tool open and closed, flowing and shut-in pressures, whether shut-in pressure reached static level, hydrostatic pressures, bottom hole temperature, fluid recovery, and flow rates if gas to surface during test. Attach extra sheet if more space is needed. Attach copy of log.

Drill Stem Tests Taken Yes No
 Samples Sent to Geological Survey Yes No
 Cores Taken Yes No

Formation Description
 Log Sample

DST #1: 4579-4619 (Cherokee)
 30-30-30-30; No pressures.
 Recovered 10' Drlg. Mud.

DST #2: 4603-4655 (Mississippi)
 30-45-30-45; ISIP 412,
 FSIP 299, IF 62/144, FF 114/
 124. Hydrostatic 2285/2264.
 Recovered 110' Drlg. Mud,
 60' Oil specked and
 slightly gas cut mud.

Name	Top	Bottom
HEEBNER	3944	
BRN LIME	4098	
LANSING	4118	
BKC	4455	
CHEROKEE SH	4579	
MISSISSIPPI	4617	
KINDERHOOK	4665	
VIOLA	4750	
SIMPSON	4849	
TD	4878	

CASING RECORD New Used

Report all strings set-conductor, surface, intermediate, production, etc.

Purpose of String	Size Hole Drilled	Size Casing Set (In O.D.)	Weight Lbs/Ft.	Setting Depth	Type of Cement	#Sacks Used	Type and Percent Additives
SURFACE	12 1/2"	8.5/8"	23#	411'	common	325	3% gel. 2% ca.

PERFORATION RECORD

Acid, Fracture, Shot, Cement Squeeze Record

Shots Per Foot	Specify Footage of Each Interval Perforated	(Amount and Kind of Material Used)	Depth
D & A			

TUBING RECORD

Size Set At Packer at Liner Run Yes No

Date of First Production	Producing Method
D & A	<input type="checkbox"/> Flowing <input type="checkbox"/> Pumping <input type="checkbox"/> Gas Lift <input type="checkbox"/> Other (explain).....

Estimated Production Per 24 Hours	Oil Bbls	Gas MCF	Water Bbls	Gas-Oil Ratio	Gravity
D & A				CFPB	

METHOD OF COMPLETION

Production Interval

Disposition of gas: Vented Open Hole Perforation
 Sold Other (Specify)
 Used on Lease Dually Completed
 Commingled