

STATE OF KANSAS
STATE CORPORATION COMMISSION

Give All Information Completely
Make Required Affidavit
Mail or Deliver Report to:
Conservation Division
State Corporation Commission
211 No. Broadway
Wichita, Kansas

WELL PLUGGING RECORD

KIOWA County, Sec. 17 Twp. 29S Rge. (E) 17 (W)

Location as "NE/CNWxSWx" or footage from lines CENTER NE/4 NW/4

Lease Owner REX & MORRIS DRILLING COMPANY, ET AL

Lease Name JOHN Well No. 1

Office Address P. O. BOX 334, EL DORADO, KANSAS

Character of Well (completed as Oil, Gas or Dry Hole) DRY HOLE

Date well completed 25 JULY 19 62

Application for plugging filed 25 JULY 19 62

Application for plugging approved 25 JULY 19 62


Plugging commenced 26 JULY 19 62

Plugging completed 26 JULY 19 62

Reason for abandonment of well or producing formation DRY HOLE

If a producing well is abandoned, date of last production NONE 19

Was permission obtained from the Conservation Division or its agents before plugging was commenced? YES

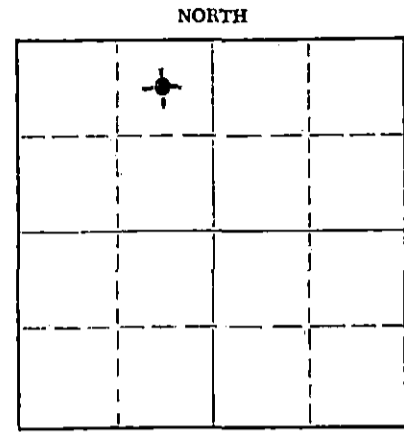

Locate well correctly on above Section Plat

Name of Conservation Agent who supervised plugging of this well HERMAN JUSTUS

Producing formation NONE Depth to top Bottom Total Depth of Well 4905' RB Feet

Show depth and thickness of all water, oil and gas formations.

OIL, GAS OR WATER RECORDS

CASING RECORD

FORMATION	CONTENT	FROM	TO	SIZE	PUT IN	PULLED OUT
<u>SURFACE HOLE</u>	<u>WATER</u>	<u>SURFACE</u>	<u>362' RB</u>	<u>8 5/8" OD</u>	<u>356.39'</u>	<u>LEFT IN</u>
<u>(SEE ATTACHED LOG)</u>						

Describe in detail the manner in which the well was plugged, indicating where the mud fluid was placed and the method or methods used in introducing it into the hole. If cement or other plugs were used, state the character of same and depth placed, from feet to feet for each plug set.

FILLED HOLE WITH DRILLING MUD TO 220', SET PLUG AND CEMENTED WITH 20 SACKS CEMENT, FILLED HOLE WITH DRILLING MUD TO 40', SET PLUG AND CEMENT WITH 10 SACKS CEMENT, PUT 2 SACKS CEMENT IN RAT HOLE.

RECEIVED
STATE CORPORATION COMMISSION

AUG 1 1962

CONSERVATION DIVISION
Wichita, Kansas

(If additional description is necessary, use BACK of this sheet)

Name of Plugging Contractor REX & MORRIS DRILLING COMPANY

Address P. O. BOX 334, EL DORADO, KANSAS

STATE OF KANSAS, COUNTY OF BUTLER, ss.

A. H. FISHER (employee of owner) ~~or (conservator)~~ of the above-described

well, being first duly sworn on oath, says: That I have knowledge of the facts, statements, and matters herein contained and the log of the above-described well as filed and that the same are true and correct. So help me God.

(Signature) A. H. Fisher

P. O. BOX 334, EL DORADO, KANSAS

(Address)

Subscribed and Sworn to before me this 31ST day of JULY, 19 62

My commission expires 8 AUGUST 1962

Elizabeth Deschner
ELIZABETH DESCHNER Notary Public.



Y O H N # 1

Rex & Morris Drilling Company

Total Depth: 4905
Contractor: Rex & Morris
Commenced: 7-14-62
Completed: 7-25-62
Initial Production: D. & A.

Location: C. NE NW
Section 17-29S-17W
Kiowa County, Kansas
Casing Record:
8 5/8 @ 362' w/225 sacks

FORMATION	DEPTH
Surface Hole	362
Shale	1042
Anhydrite	1067
Shale	1310
Shale and Shells	1930
Lime and Shale	2225
Lime	2380
Lime and Shale	2535
Lime	2892
Lime and Shale	3014
Lime	3180
Lime and Shale	3465
Lime	3570
Lime and Shale	3705
Lime	4040
Lime and Shale	4195
Shale and Lime	4226
Lime	4790
Lime and Shale	4805
Chat	4888
Lime	4905

RTD

RECEIVED
STATE CORPORATION COMMISSION
AUG 1 1962
CONSERVATION DIVISION
Wichita, Kansas

I hereby certify the foregoing statements are true and correct to the best of my knowledge and belief.

Rex & Morris Drilling Company
By Paul D. Koontz
Paul D. Koontz, Geologist

STATE OF KANSAS
COUNTY OF BUTLER, SS.

Subscribed and sworn to before me, a Notary Public, this 31st day of July, 1962.

Elizabeth Deschner
Elizabeth Deschner, Notary Public

My commission expires: August 8, 1962.