


Give All Information Completely
Make Required Affidavit
Mail or Deliver Report to:
Conservation Division
State Corporation Commission
211 No. Broadway
Wichita, Kansas

WELL PLUGGING RECORD

NORTH

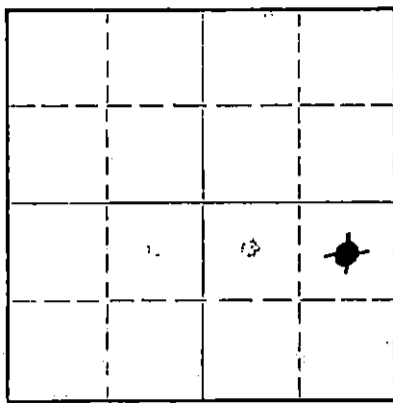

Locate well correctly on above
Section Plat

Kiowa County. Sec. 16 Twp. 29S Rge. (E) 17 (W)
Location as "NE/CNW&SW" or footage from lines C NE SE
Lease Owner Jas. F. Smith
Lease Name Conklin Well No. 1-16
Office Address P. O. Box 10005, Amarillo, Texas
Character of Well (completed as Oil, Gas or Dry Hole) Dry Hole
Date well completed December 16, 19 63
Application for plugging filed February 25, 19 64
Application for plugging approved February 27, 19 64
Plugging commenced March 4, 19 64
Plugging completed March 6, 19 64
Reason for abandonment of well or producing formation Dry Hole

If a producing well is abandoned, date of last production _____ 19 ____
Was permission obtained from the Conservation Division or its agents before plugging was commenced? Yes

Name of Conservation Agent who supervised plugging of this well A. Elving
Producing formation None Depth to top _____ Bottom _____ Total Depth of Well 4848 Feet
Show depth and thickness of all water, oil and gas formations.

OIL, GAS OR WATER RECORDS

CASING RECORD

FORMATION	CONTENT	FROM	TO	SIZE	PUT IN	PULLED OUT
	This was an old well work-over.	See		4-1/2"	4848'	3508'
	Well Plugging Record filed by					
	Cooperative Refinery Association					
	(Conklin "A" #1).					

Describe in detail the manner in which the well was plugged, indicating where the mud fluid was placed and the method or methods used in introducing it into the hole. If cement or other plugs were used, state the character of same and depth placed, from _____ feet to _____ feet for each plug set.

Pumped 15 sacks cement to plug off perforations, stopping plug at 4664'.
Lay down 3508' of casing, stopping casing at 250' and pumping 40 sacks of
cement. Rock bridge at 40' to 30' and 10 sacks cement from 30' to surface.
Cut off pipe 3' below ground level.

RECEIVED
STATE CORPORATION COMMISSION

MAR 16 1964

CONSERVATION DIVISION
Wichita, Kansas

(If additional description is necessary, use BACK of this sheet)

Name of Plugging Contractor Sargent's Casing Pulling Service
Address 121 West 9th, Liberal, Kansas

STATE OF TEXAS COUNTY OF POTTER, ss.
L. E. Geoffroy (employee of owner) ~~XXXXXXXXXXXX~~ of the above-described

well, being first duly sworn on oath, says: That I have knowledge of the facts, statements, and matters herein contained and the log of the above-described well as filed and that the same are true and correct. So help me God.

(Signature) [Signature]
P. O. Box 10005, Amarillo, Texas
(Address)

SUBSCRIBED AND SWORN TO before me this 13th day of March, 19 64

My commission expires June 1, 1965 [Signature] Notary Public.