


STATE OF KANSAS
STATE-CORPORATION COMMISSION

WELL PLUGGING RECORD

Give All Information Completely
Make Required Affidavit
Mail or Deliver Report to:
Conservation Division
State Corporation Commission
211 No. Broadway
Wichita, Kansas

Kiowa County, Sec 16 Twp. 29S Rge. (E) 17 (W)
Location as "NE/CNW/SW" or footage from lines C NE SE
Lease Owner Cooperative Refinery Ass'n.
Lease Name Conklin Well No. 1
Office Address Box 765 Gt. Bend, Ks.
Character of Well (completed as Oil, Gas or Dry Hole) Dry hole
Date well completed Feb. 22 19 58
Application for plugging filed Feb. 24 19 58
Application for plugging approved Verbal permission obtained 19
Plugging commenced Feb. 22 19 58
Plugging completed Feb. 22 19 58
Reason for abandonment of well or producing formation Dry hole

NORTH

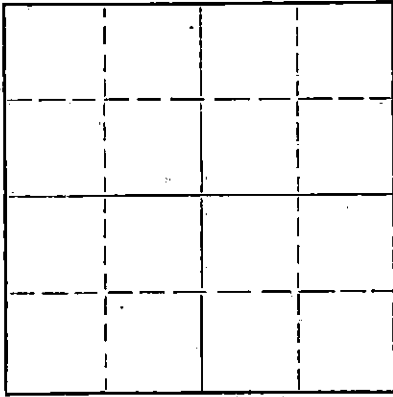

Locate well correctly on above
Section Plat

If a producing well is abandoned, date of last production 19
Was permission obtained from the Conservation Division or its agents before plugging was commenced? yes

Name of Conservation Agent who supervised plugging of this well W. L. Lackamp, Jr.
Producing formation Depth to top Bottom Total Depth of Well 4830 Feet
Show depth and thickness of all water, oil and gas formations.

OIL, GAS OR WATER RECORDS

CASING RECORD

FORMATION	CONTENT	FROM	TO	SIZE	PUT IN	PULLED OUT
				8 5/8"	256'	-0-

Describe in detail the manner in which the well was plugged, indicating where the mud fluid was placed and the method or methods used in introducing it into the hole. If cement or other plugs were used, state the character of same and depth placed, from feet to feet for each plug set.

Filled with heavy mud to 240', set plug and bridge at 240', used 20 sx. cement through 4 1/2" drill pipe at 240'. Heavy mud to 40', set plug and bridge, 10 sax cement to surface.

RECEIVED
STATE CORPORATION COMMISSION

FEB 26 1958

CONSERVATION DIVISION
1958

2-26-58

(If additional description is necessary, use BACK of this sheet)

Name of Plugging Contractor Shields Drlg. Co.
Address Russell, Kansas

STATE OF KANSAS, COUNTY OF BARTON, ss.
JOHN H. NATTON (employee of owner) or (owner or operator) of the above-described well, being first duly sworn on oath, says: That I have knowledge of the facts, statements, and matters herein contained and the log of the above-described well as filed and that the same are true and correct. So help me God.

(Signature) John H. Natton
Box 765 Gt. Bend, Ks.
(Address)

SUBSCRIBED AND SWORN TO before me this 24 day of February, 19 58

My commission expires Sept, 24, 1960

Notary Public.

PLUGGING
FILE SEC 16 T. 29 R. 174
BOOK PAGE 85 LINE 22

DRILLERS LOG

Conklin #1

Elevation: 2111 K.B.

Loc: C NE SE
 Sec: 16-29S-17W

Casing: 8 5/8" @ 256' w/ 225 sx.

Kiowa County, Kansas

Operator: Cooperative Refinery Ass'n.

Comm: 2-4-58 Comp: 2-22-58

Contractor: Shields Drlg. Company

Total Depth: 4830'

From	To	Formation
0	25	Shale
25	95	Sand
95	525	Shale
525	1530	Redbed and shale
1530	2100	Shale and shells
2100	2392	Shale with lime
2392	2485	Lime and sand
2485	3284	Shale with lime streaks
3284	3698	Shale and lime
3698	3885	Lime with shale streaks
3885	4060	Lime
4060	4160	Lime and shale
4160	4830	Lime
4830		R.T.D.

RECEIVED
 STATE CORPORATION COMMISSION
 FEB 26 1958
 CONSERVATION DIVISION
 Wichita, Kansas

(STATE OF KANSAS)

(COUNTY OF BARTON)

I hereby certify that the above is a true and correct copy of the log on the Conklin #1 well, located C NE SE of Section 16-29S-17W, Kiowa County, Kansas.

John H. Nation

Subscribed and sworn to before me this 24 day of February 1958.

Yvonne Adams

My commission expires: September 24, 1960.

PLUGGING
 FILE SEC. 16 T. 29 R. 17W
 BOOK PAGE 85 LINE 22